

WATER WELL RECORD

Form WWC-5


Division of Water Resources App. No.

1 LOCATION OF WATER WELL: County: Montgomery	Fraction ¼ NE ¼ NE ¼ SW ¼	Section Number 25	Township No. T 32 S	Range Number R 15 <input checked="" type="checkbox"/> E <input type="checkbox"/> W
--	------------------------------	----------------------	------------------------	---

Street/Rural Address of Well Location; if unknown, distance & direction from nearest town or intersection: If at owner's address, check here .
Earth Care Products (Formerly Automotive Controls Corporation)
800 North 21st Street,

Global Positioning System (GPS) information:
Latitude: N37.231752777 (in decimal degrees)
Longitude: W95.724158333 (in decimal degrees)
Elevation:
Datum: WGS 84, NAD 83, NAD 27
Collection Method:
 GPS unit (Make/Model:)
 Digital Map/Photo, Topographic Map, Land Survey
Est. Accuracy: <3 m, 3-5 m, 5-15 m, >15 m

2 WATER WELL OWNER: Earth Care Products (Former ACC)
RR#, Street Address, Box #: 800 North 21st Street
City, State, ZIP Code : Independence, Kansas 67301

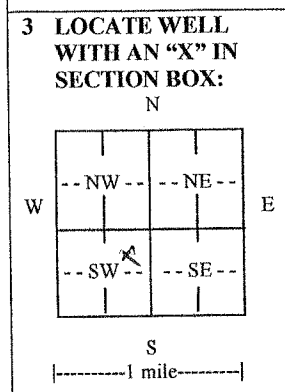

4 DEPTH OF COMPLETED WELL 12 ft.
Depth(s) Groundwater Encountered (1) Drv ft. (2) N/A ft. (3) N/A ft.
WELL'S STATIC WATER LEVEL Drv ft. below land surface measured on mo/day/yr. 3-19-12
Pump test data: Well water was N/A ft. after N/A hours pumping. N/A gpm
EST. YIELD N/A gpm. Well water was N/A ft. after N/A hours pumping. N/A gpm
Bore Hole Diameter 8.25 in. to 12 ft., and N/A in. to N/A ft.
WELL WATER TO BE USED AS: Public water supply Geothermal Injection well
 Domestic Feedlot Oil field water supply Dewatering Other (Specify below)
 Irrigation Industrial Domestic-lawn & garden Monitoring well PS-Ca
Was a chemical/bacteriological sample submitted to Department? Yes No
If yes, mo/day/yr sample was submitted N/A
Water well disinfected? Yes No

5 TYPE OF CASING USED: Steel PVC Other
CASING JOINTS: Glued Clamped Welded Threaded
Casing diameter 2 in. to 4 ft., Diameter N/A in. to N/A ft., Diameter N/A in. to N/A ft.
Casing height above land surface 0 in., Weight N/A lbs./ft., Wall thickness or gauge No. Schedule 40
TYPE OF SCREEN OR PERFORATION MATERIAL:
 Steel Stainless Steel PVC Other (Specify)
 Brass Galvanized Steel None used (open hole)
SCREEN OR PERFORATION OPENINGS ARE:
 Continuous slot Mill slot Gauze wrapped Torch cut Drilled holes None (open hole)
 Louvered shutter Key punched Wire wrapped Saw cut Other (specify)
SCREEN-PERFORATED INTERVALS: From 4 ft. to 12 ft., From N/A ft. to N/A ft., From N/A ft. to N/A ft.
GRAVEL PACK INTERVALS: From 3 ft. to 12 ft., From N/A ft. to N/A ft., From N/A ft. to N/A ft.

6 GROUT MATERIAL: Neat cement Cement grout Bentonite Other Concrete 0 to 2
Grout Intervals: From 2 ft. to 3 ft., From N/A ft. to N/A ft., From N/A ft. to N/A ft.
What is the nearest source of possible contamination:
 Septic tank Lateral lines Pit privy Livestock pens Insecticide storage Other (specify below)
 Sewer lines Cesspool Sewage lagoon Fuel storage Abandoned water well
 Watertight sewer lines Seepage pit Feedyard Fertilizer storage Oil well/gas well Frmr Auto Cont. Corp
Direction from well North Distance from well <25-feet

FROM	TO	LITHOLOGIC LOG	FROM	TO	LITHO. LOG (cont.) or PLUGGING INTERVALS
0	4.5	<u>silt clay - brown</u>			
4.5	7.4	<u>weathered shale - brown</u>			
7.4	11.4	<u>shale - grayish yellow</u>			

7 CONTRACTOR'S OR LANDOWNER'S CERTIFICATION: This water well was constructed, reconstructed, or plugged under my jurisdiction and was completed on (mo/day/year) 3-19-12 and this record is true to the best of my knowledge and belief. Kansas Water Well Contractor's License No. 759 This Water Well Record was completed on (mo/day/year) 6-9-12 under the business name of RAZEK Environmental, LLC by (signature) [Signature]

INSTRUCTIONS: Use typewriter or ball point pen. PLEASE PRESS FIRMLY and PRINT clearly. Please fill in blanks and check the correct answers. Send three copies (white, blue, pink) to Kansas Department of Health and Environment, Bureau of Water, Geology Section, 1000 SW Jackson St., Suite 420, Topeka, Kansas 66612-1367. Telephone 785-296-5524. Send one copy to WATER WELL OWNER and retain one for your records. I include fee of \$5.00 for each constructed well. Visit us at <http://www.kdheks.gov/waterwell/index.html>.