
KOLAR Document ID: 1589108

LOCATION OF WATER WELL:   Fraction		WELL R	RECORD Correction		WWC-5 e in Well Use				ion of Wate			$\bigcup_{\mathbf{w}}$	ell ID		
Variable									11						
Address: Address: Address: Static Sta	2 WELL	OWNER: 1	ast Name:		First:		Street or	Rura	l Address	wher	e well is locate	d (if u	ınknown,	distance and	
Address   State:							direction fro	om ne	arest town or	r inters	section): If at own	ner's a	ddress, c	heck here:	
SUCCATE WELL WITH YE'IN SCOTION ROX:    A DEPTH OF COMPLETED WELL:															
Depth(s) Groundwater Encountered: 1		E WELL			IDI EWED Y	WEST T		C		_					
2								. It.						_	
WELL'S STATE WATER LEVEL:								1							
SW			_												
after hours pumping gpm	w <sub> </sub>	E	arter							nline	Mapper:				
Settanted Yield:	SW	SE	after												
mile			Estimated Y	ield:	gpm										
2															
Air Sparge			8.	Monitorin	g: well ID				12. Geoth	nerma	l: how many bo	es?			
Mas a chemical/bacteriological sample submitted to KDHE?   Yes   No   If yes, date sample was submitted:   Water well disinfected?   
Nater well disinfected?   Yes   No								, 1							

Casing height above land surface in Weight   lbs./ft   Wall thickness or gauge No.  TYPE OF SCREEN OR PERFORATION MATERIAL:														Ппеацец	
Steel   Stainless Steel   PVC   Other (Specify)   SCREN OR PERFORATION OPENINGS ARE:   Ontinuous Slot   Mill Slot   Gauze Wrapped   Torch Cut   Drilled Holes   Other (Specify)   Other (Speci															
SCREEN OR PERFORATION OPENINGS ARE:   Continuous Slot				TION MA											
SCREEN OR PERFORATION OPENINGS ARE:   Continuous Slot   Mill Slot   Gauze Wrapped   Torch Cut   Drilled Holes   Other (Specify)   Other	_	_			-	_	1/	1.		ner (S	pecify)				
Continuous Slot   Mill Slot   Gauze Wrapped   Saw Cut   None (Open Hole)				NINGS A		_ None	used (open l	iole)							
Louvered Shutter   Key Punched   Wire Wrapped   Saw Cut   None (Open Hole)   SCREN-PERFORATED INTERVALS: From						Πт	orch Cut - F	7 Dri	illed Holes	П	Other (Specify)				
GRAVEL PACK INTERVALS: From											stiler (Specify)	•••••			
Grout Intervals: From															
Nearest source of possible contamination:   No potential source of contamination within 200 ft.   Septic Tank															
Septic Tank										•••••	ft. to		ft.		
Sewer Lines										ne	□ Insec	ticide	Storage		
Watertight Sewer Lines								_						Vell	
Direction from well?															
11 CONTRACTOR'S OR LANDOWNER'S CERTIFICATION: This water well was constructed, reconstructed, or plugged under my jurisdiction and was completed on (mo-day-year) and this record is true to the best of my knowledge and belief. Kansas Water Well Contractor's License No. This Water Well Record was completed on (mo-day-year)												_			
Notes:    Notes:						e from v							HOOING	SINTERNALC	
Kansas Water Well Contractor's License No. This Water Well Record was completed on (mo-day-year) under the business name of Send one copy to WATER WELL OWNER and retain one for your records. Fee of \$5.00 for each constructed well.															
under the business name of	Kansas Wa	ter Well Co	ntractor's Lice	ense No		This W	ater Well l	Reco	rd was con	nplet	ed on (mo-day-	year)			
Send one copy to WATER WELL OWNER and retain one for your records. Fee of \$5.00 for each constructed well.	under the b	usiness nam	e of												
KS Department of Health and Environment, Bureau of Water, Geology Section, 1000 SW Jackson St., Suite 420, Topeka, Kansas 66612-1367. Telephone 785-296-3565.	KS Departn	nent of Health	Send one copy to and Environment	o WATER W , Bureau of V	'ELL OWNER a Vater, Geology S	and retain Section, 1	one for your 000 SW Jack	record son St	ds. Fee of \$5 t., Suite 420,	5.00 fo Topek	r each <u>constructed</u> ca, Kansas 66612-1	well. 367. T	elephone	785-296-3565.	

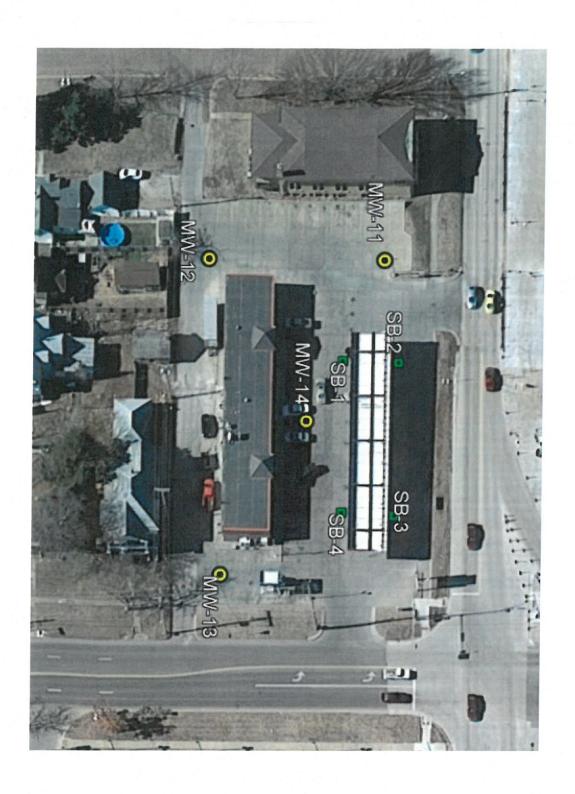

	BORING LOG / MONITORING WELL SCHEMATIC										
ВН	/MW No.			Location	on of Drill Hole		Well ID Tag No.		Driller	Geologist	
MW-11 Soc Mus								6	Presley	School	
Water Level Depths					PS Coordinates		Type of Surfa		1	Drill Rig	
100	During			Lat:	1/27 22-	Asphal	It - Concrete )- (	Grass	- Gravel	5530h	
	Drilling			Lat.	N3+.22311		Drilling Method / Sa	g Method	Total Depth		
100	End of Orilling			Long:	WB.71174	1	fir Rotery	16	Mings	15	
		ample Dat	a			escription			We	ell Construction	
Dpth Ft.	Dpth No. & Rcvr. PID			uscs	(include	Description USCS class Consistency - Co		Dpth Ft.	Schematic	Details	
10					Concrete i It Reddish t  Istuestone  Dile gray		on Sendy cluy	10		Elevation  Casing: Pad: Protective Cover  Type: flushmouth t Size: 7"X10"  Pad Size flushmouth t Size: 7"X10"  Well Seal  Type: Benton i te Amount: 5016  Water: (5g/50lbs) 5 quid  Well Pack  Type: 12/20 Sud  Amount: 2516	
20								20		Riser  Type: Duc  Schedule: 40  Inside Diam.: 2 "  Length: 5'  Screen	
25								25		Type: PVC Schedule: L(1) Slot: O. D. I Inside Diam.: 21' Length: 10'	
30				Harl				30		End Cap Type: PVC	
35								35		Length: 2"  Date Drilled: 7-14-7  Date Completed: 8-11-21 7-24-2	
Project Name: Convenience Store											
		S			7th Street South	Project L			pendence	.ore	
F	ngin	eeri		316-554		Signature	e: /	5	her		
	-5.11		5			Mula a se					
						GSI Job. No: 1774084 Date: 8-11-21					

				ВО	RING LOG / MC	NITORII	NG WELL SCHE	MAT	TIC		
BH/	MW No.		1	Locatio	on of Drill Hole		Well ID Tag No.	Driller	Geologist		
MW-12 See Miss								Preslect	Towel		
Water Level Depths GPS Coordinates							Type of Surfa	'	Drill Rig		
During Drilling Lat: N 37, 200					1/21 2218	Asphal	SS 30h Total Depth				
End of				Long:	1106.71176		Drilling Method / Sa		11	1/1/1	
D	rilling			Long.	043 +1113	1/	fir Koter	4/	work	S / / D	
Sample Data  Sample % Dpth No. & PID				USCS	Geological	Description USCS class	& Remarks	Dpth	Details		
Ft.	Туре	Rcvr.			Moisture - Plasticity - C	onsistency - Co	olor - Odor - Particulates	Ft.			
5							bn Sendef Way	5	W Sa	Elevation  Casing: Pad: Protective Cover	
3					Lines to me	61 1				Typeflich want Size: 7"X70" Pad Size: 6"	
10			•••••		The gray to	) (C)(CM)	Sherr	10	11111	Type: Berton i te Amount: 50 lb Water: (5g/50lbs) 50 el	
15								15	1)))	Well Pack Type: /2/20 Sund Amount: 250 / b Riser	
20								20		Type: T.C. Schedule:40 Inside Diam:2" Length:5	
25								25		Screen  Type: PVC Schedule: 40 Slot: 20 Inside Diam.: 2"	
30								30		Length: O End Cap  Type: PVC	
35								35		Length: 2"  Date Drilled: 9-14  Date Completed: 9-14	
Project Name: Convenience Store									tore		
		76	The second second		47th Street South		1	pendence			
T	maria				, KS 67210 I-0725	Signatur	111 01		9-24-21		
E	Engin	ieer	ing	310-336	0,23		No: 1774084	Date:	Q-TL-9A		
						GOI JOB.	11/4004	Date: Silled			

	BORING LOG / MONITORING WELL SCHEMATIC									
BH/	MW No.				on of Drill Hole		Well ID Tag No.		Driller	Geologist
nı	W-13	3	0 /	Neep				(1)	Prestey	TS hood
	Water Le	vel Dep	-		PS Coordinates		Type of Surfa		1	Drill Rig
the second second second	uring			Lat: ///27		Aspha				5530h
	rilling			Lut.	1437.		Drilling Method / Sar	mpling	g Method	Total Depth
	nd of rilling			Long:	0 10	Aic	Robert	Cu	Hings	15
	Sample	mple Dat	a			Description	& Remarks		O We	ell Construction
Dpth Ft.	No. & Type	% Rcvr.	PID	uscs	(include l Moisture - Plasticity - Co	USCS class onsistency - Co	sification) blor - Odor - Particulates	Dpth Ft.	Schematic	Details
10 15 20 25					Concreta, 1' 1+ Riddish  LimeStone  Drb gay +		Shell	10 15 20 25		Elevation  Casing: Pad:  Protective Cover  Type: Account of the control of the co
								25		Date Completed:
35								35		
1		16	T	4502.5		Project I			venience S	tore
		T			47th Street South , KS 67210	Project I	ocation:	Inde	pendence	
	ngin					Signatuı	e: They	Sh	re-	9-24-21
	0		0			GSI Job	No: 1774084		Date:	S-H-21
										GSI Log 0-35 Rv.2019

BORING LOG / MONITORING WELL SCHEMATIC												
BH/MW No.			Location	on of Drill Hole		Well ID Tag No.		Driller	Geologist			
MW-14	See H	you	rded	Men Location	1		Al	WATESleet	School			
	evel Depth	is	G	PS Coordinates		Type of Surfa		Drill Rig				
During Drilling			Lat:	1/27		t - Concrete Drilling Method / Sa		- Gravel	Total Depth			
End of				/ V() r -	1	Drilling Wethod / Sa		///	Total Depth			
Drilling			Long: W95. His Kotory/					utting 15'				
	ample Data				scription		We	ell Construction				
Dpth No. & Type	% Rcvr.	PID	USCS	Moisture - Plasticity - Co	JSCS class ensistency - Co	sification) blor - Odor - Particulates	Dpth Ft.	Schematic	Details			
5				Concrete l' It Reddish to a			5	2	Pad:  Protective Cover  Type: Fishers of Size: 7'X10'			
10				This line & Dit gray to	blh.	Shele	10		Pad Size: 6  Well Seal  Type: Bestin 1 fe  Amount: 53 16  Water: (5g/50lbs) 54gul  Well Pack			
20							20		Type: DC  Amount: 250 L  Riser  Type: DC  Schedule: 40 Inside Diam.: 2*  Length: 51			
25							25		Type: DC Schedule: UO Slot: D-OI Inside Diam.: 9			
30							30		End Cap  Type: PVC  Length: 2"  Date Drilled:			
35							35		Date Completed: 8-11-21 874			
	70	_			Project N	lame:	Con	venience St	tore			
-(	1.5	4		17th Street South	Project L	ocation:	Inde	pendence				
	Wichita, KS 67210  Froject Location: Independence  Signature:											

GSI Job. No: 1774084

Date: 8-11-2