
## KOLAR Document ID: 1589114

	WELL R	ECORD Correction		<b>WWC-5</b> e in Well Use		vision of Wa ources App.			Well ID			
		ATER WEL		Fraction		ction Numb		Township Numbe		ge Number		
County					1/4 1/4	$\begin{array}{c} \text{T}  \text{S} \\ \text{T}  \text{S} \\ \text{R}  \square \text{ E}  \square \text{ W} \end{array}$						
	OWNER: La	ast Name:		First:	Street or Ru	Street or Rural Address where well is located (if unknown, distance and						
Business:					direction from	nearest town	or inte	rsection): If at owner'	's address,	check here:		
Address: Address:												
City:			State:	ZIP:								
3 LOCAT	E WELL		OF COM	DI ETED WELL.			. 1					
WITH "				IPLETED WELL: Encountered: 1)				· · · · · · · · · · · · · · · · · · ·				
SECTIO				3) ft., or 4)		Long	gitua	e:   WGS 84 □ NAD		(decimal degrees)		
r	N			TER LEVEL:				Latitude/Longitude:		AD 21		
				, measured on (mo-day				unit make/model:		)		
NW	NE			, measured on (mo-day			(WAAS enabled? ☐ Yes ☐ No)					
		~		vater wass pumping				Survey				
W	E	alter		vater was			Onlin	e Mapper:				
SW	SE	after		s pumping								
		Estimated Y			01	6 Elevation:ft. 🗆 Grou						
	S	Bore Hole D		in. to		Sour		Land Survey 🔲 G				
1 r		DE LICED		in. to	ft.							
7 WELL WATER TO BE USED AS:         1. Domestic:       5. <ul> <li>Public Water Supply: well ID</li> <li>10.              <li>Oil Field Water Supply: lease</li> </li></ul>												
T. Domestic. ☐ House				ig: how many wells?.								
				echarge: well ID								
Livesto	ock			g: well ID				al: how many bores				
2. 🗌 Irrigati				al Remediation: well				l Loop 🔲 Horizonta				
3. 🗌 Feedlo			Air Sparge		Extraction	b) Open Loop 🗌 Surface Discharge 🔲 Inj. of Water						
4. 🗌 Industr			Recovery	5				(specify):				
				itted to KDHE?	]Yes 🗌 No	If yes, da	te sai	mple was submitted	1:			
		Yes		<u> </u>	C A G		<u> </u>					
				C Other						I [] Threaded		
				Diameter				s or gauge No				
		PERFORAT				vv an une	chilest	5 of gauge 110				
☐ Steel		less Steel					ther (	Specify)				
Brass		anized Steel			used (open ho	le)		1 57				
		ATION OPE										
	nuous Slot	☐ Mill Slot			Forch Cut	Drilled Holes		Other (Specify)	•••••			
	ered Shutter	Key Punch		Vire Wrapped $\Box$ S n ft. to		None (Open			ft to	f4		
				n ft. to								
				Cement grout $\Box$ E								
				ft., From								
		e contaminati	on: No	potential source of co								
Septic			Lateral Line			Livestock P		Insectici				
Sewer			Cess Pool	□ Sewage L		Fuel Storag				Well		
□ Watertight Sewer Lines □ Seepage Pit □ Feedyard □ Fertilizer Storage □ Oil Well/Gas Well												
Direction from well? ft.												
10 FROM	TO		ITHOLO		FROM	TO		THO. LOG (cont.) or	PLUGGIN	G INTERVALS		
							<u> </u>					
	-											
					Notes		1					
				110105.	Notes:							
11 CONTRACTOR'S OR LANDOWNER'S CERTIFICATION: This water well was Constructed, reconstructed, or plugged												
under my j	urisdiction ar	d was compl	eted on (n	no-day-year)	and	l this record	is tru	ue to the best of my	knowled	ge and belief.		
Kansas Water Well Contractor's License No												
under the b	usiness name	Send one copy to	WATER W	ELL OWNER and retain	none for your re	cords. Fee of <sup>©</sup>	 \$5 00 f	for each constructed wel	<u></u> 1	·····		
KS Departr										785-296-3565.		
	KS Department of Health and Environment, Bureau of Water, Geology Section, 1000 SW Jackson St., Suite 420, Topeka, Kansas 66612-1367. Telephone 785-296-3565. Visit us at http://www.kdheks.gov/waterwell/index.html KSA 82a-1212											

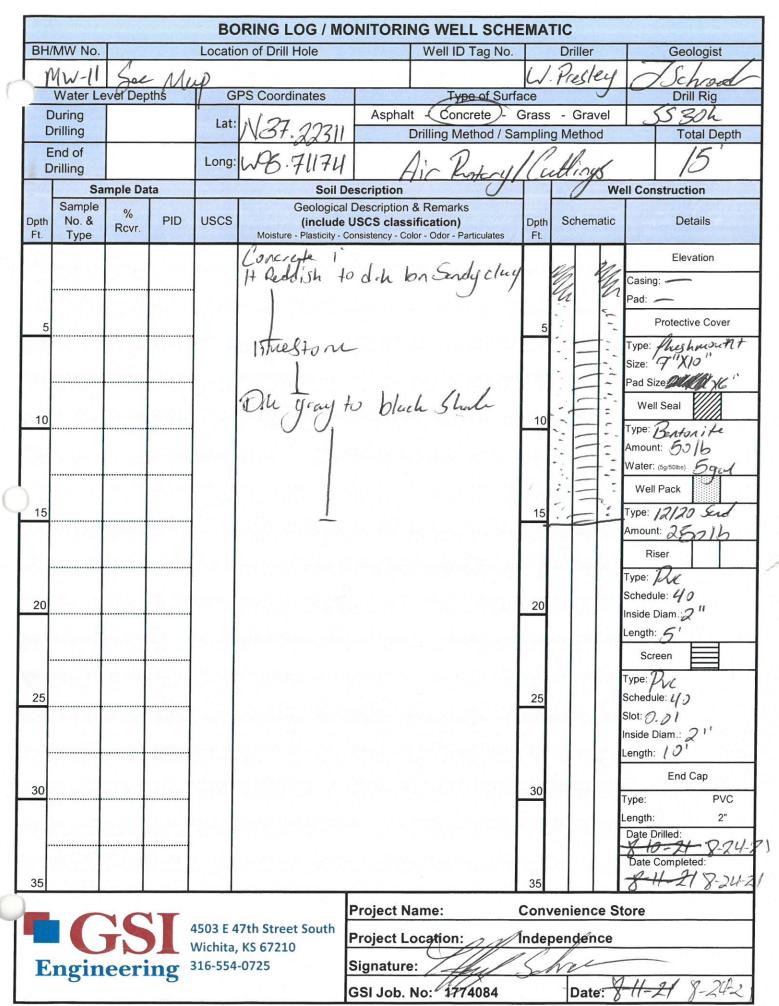




				BC	RING LOG / MC	DNITORI	NG WELL SCHI	EMA	ГІС			
BH/	MW No.	1.19		Locatio	on of Drill Hole		Well ID Tag No.		Driller	See See	Geologist	
MW-12 See			Miri	)			U	Prester	Flowset			
Water Level Depths			Ģ	PS Coordinates		Type of Surf	ace	' /	00	Drill Rig		
During Drilling		Lat: 1 27 2228		Asphalt - Concrete - C Drilling Method / Sar				1.55	Total Depth			
End of		Long	105 71170	NATURA A Q					1/1			
Drilling			Long: W45 7/179 Air Koter					Luting	B	15		
	Sample Data				escription ' Description & Remarks			Ŋye	Const	Construction		
Dpth Ft.	No. & Type	% Rcvr.	PID	USCS	(include Moisture - Plasticity - C	USCS class consistency - Co	sification) olor - Odor - Particulates	Dpth Ft.	Schematic		Details	
5 10 15 20 25 30					Concrete It Reddish to Linestone Dile group to		bn Sendef Ung	5 10 15 20 25 30		Type: 7 Pad Size Well S Type: 7 Amount: Water: (5) Well Part Type: 7 Amount: Rise Type: 7 Schedule Inside Dia Length: 7 Schedule Slot: 7 Schedule Slot: 7 Schedule Slot: 7 Type: 7 Schedule Slot: 7 Schedule Schedule Slot: 7 Schedule Slot: 7 Schedule Sch	$\begin{array}{c}                                     $	
35								35		- Je	Hod J.M	
						Project I	Name:	Con	venience S	tore		
					47th Street South	IProject L ocation'a/			Independence			
<b>Engineering</b> Wichita, KS 67210 316-554-0725						Signatur	e. Harts	ha		9.2	4-21	
Lingineering							No: 1774084	- 26	Date:	QIT	E-9A	


1

(

GSI Log 0-35 Rv.2019

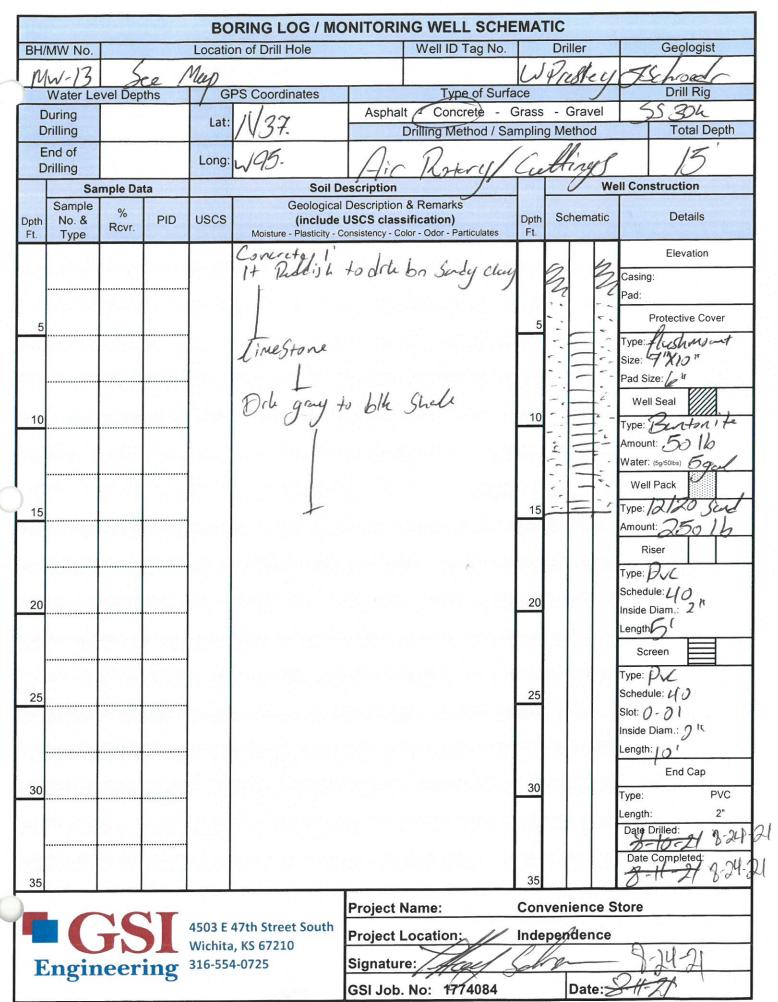

GSI Log 0-35 Rv.2019

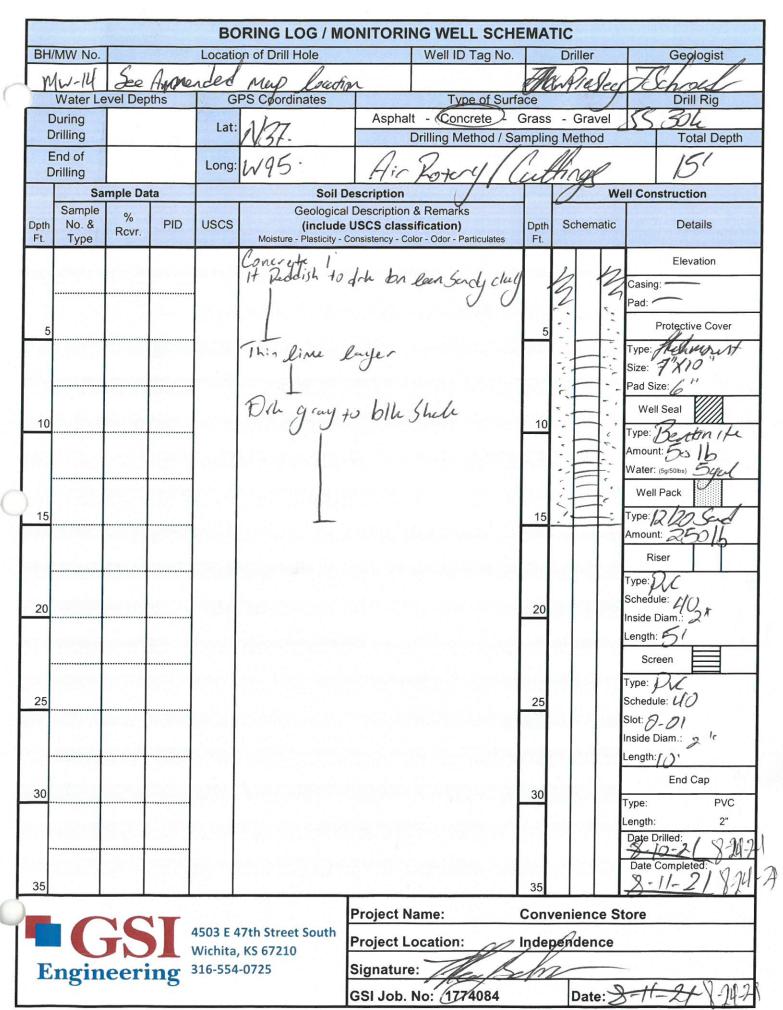

GSI Log 0-35 Rv.2019