


1 LOCATION OF WATER WELL: Fraction NE 1/4 NE 1/4 NE 1/4 Section Number 31 Township Number T 32 S Range Number R 16 E/W  
 County: Montgomery  
 Distance and direction from nearest town or city street address of well if located within city?  
928 E. Main

2 WATER WELL OWNER: Miller Brothers  
 RR#, St. Address, Box #: 928 E. Main Board of Agriculture, Division of Water Resources  
 City, State, ZIP Code: Independence, Kansas Application Number:

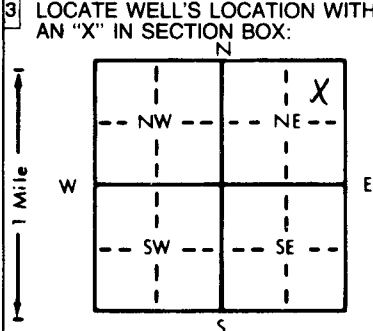

4 DEPTH OF COMPLETED WELL: 10 ft. ELEVATION:  
 Depth(s) Groundwater Encountered 1. .... ft. 2. .... ft. 3. .... ft.  
 WELL'S STATIC WATER LEVEL ..... ft. below land surface measured on mo/day/yr  
 Pump test data: Well water was ..... ft. after ..... hours pumping ..... gpm  
 Est. Yield ..... gpm: Well water was ..... ft. after ..... hours pumping ..... gpm  
 Bore Hole Diameter: 6 in. to 10 ft., and ..... in. to ..... ft.  
 WELL WATER TO BE USED AS:  
 1 Domestic 3 Feedlot 6 Oil field water supply 9 Dewatering 12 Other (Specify below)  
 2 Irrigation 4 Industrial 7 Lawn and garden only 10 Monitoring well TEST  
 Was a chemical/bacteriological sample submitted to Department? Yes.....No.....; If yes, mo/day/yr sample was submitted  
 Water Well Disinfected? Yes No

5 TYPE OF BLANK CASING USED:  
 1 Steel 3 RMP (SR) 5 Wrought iron 8 Concrete tile CASING JOINTS: Glued ..... Clamped .....  
 2 PVC 4 ABS 6 Asbestos-Cement 9 Other (specify below) Welded .....  
 7 Fiberglass Pulled Threaded .....  
 Blank casing diameter ..... in. to ..... ft., Dia ..... in. to ..... ft., Dia ..... in. to ..... ft.  
 Casing height above land surface: 0 in., weight ..... lbs./ft. Wall thickness or gauge No. ....  
 TYPE OF SCREEN OR PERFORATION MATERIAL:  
 1 Steel 3 Stainless steel 5 Fiberglass 7 PVC 10 Asbestos-cement  
 2 Brass 4 Galvanized steel 6 Concrete tile 8 RMP (SR) 11 Other (specify) NA  
 9 ABS 12 None used (open hole)  
 SCREEN OR PERFORATION OPENINGS ARE:  
 1 Continuous slot 3 Mill slot 5 Gauzed wrapped 8 Saw cut 11 None (open hole)  
 2 Louvered shutter 4 Key punched 6 Wire wrapped 9 Drilled holes  
 7 Torch cut 10 Other (specify) NA  
 SCREEN-PERFORATED INTERVALS: From 999 ft. to 999 ft., From ..... ft. to ..... ft.  
 GRAVEL PACK INTERVALS: From ..... ft. to ..... ft., From ..... ft. to ..... ft.

6 GROUT MATERIAL: 1 Neat cement 2 Cement grout 3 Bentonite 4 Other .....  
 Grout Intervals: From 10 ft. to 0 ft., From ..... ft. to ..... ft., From ..... ft. to ..... ft.  
 What is the nearest source of possible contamination:  
 1 Septic tank 4 Lateral lines 7 Pit privy 10 Livestock pens 14 Abandoned water well  
 2 Sewer lines 5 Cess pool 8 Sewage lagoon 11 Fuel storage 15 Oil well/Gas well  
 3 Watertight sewer lines 6 Seepage pit 9 Feedyard 12 Fertilizer storage 16 Other (specify below)  
 13 Insecticide storage  
 Direction from well? How many feet?

FROM	TO	LITHOLOGIC LOG	FROM	TO	PLUGGING INTERVALS
0	2	Brown silty clay	10	0	Portland cement grout
2	7	Brown weathered shale			
7	10	Gray limestone			

7 CONTRACTOR'S OR LANDOWNER'S CERTIFICATION: This water well was (1) constructed, (2) reconstructed, or (3) plugged under my jurisdiction and was completed on (mo/day/year) 9-23-98 and this record is true to the best of my knowledge and belief, Kansas  
 Water Well Contractor's License No. 607 This Water Well Record was completed on (mo/day/year) 9/31/98  
 under the business name of Davis Environmental Drilling LLC by (signature) [Signature]

OFFICE USE ONLY  
T  
R  
EW  
SEC  
1/4  
1/4