


1 LOCATION OF WATER WELL: Fraction Section Number Township Number Range Number  
 County: Montgomery NW NW NW 31 32S 16E E/W

Distance and direction from nearest town or city street address of well if located within city?  
100 N. 10th Street, Independence, KS

2 WATER WELL OWNER: Coastal Mart  
 RR #, St. Address, Box #: 2 N. Nevada 80903  
 City, State, ZIP Code: Colorado Springs, CO  
 Board of Agriculture, Division of Water Resources  
 Application Number:

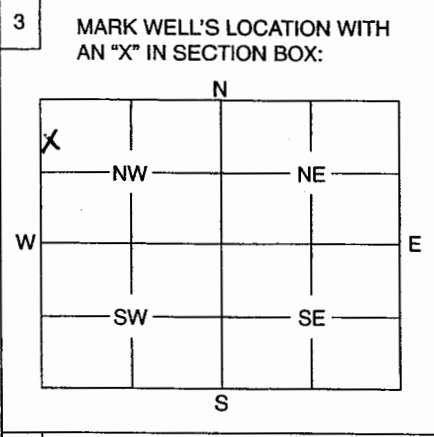

4 DEPTH OF WELL 15.05 ft.  
 WELL'S STATIC WATER LEVEL 7.70 ft.

WELL WAS USED AS:

1 Domestic	5 Public Water Supply	9 Dewatering
2 Irrigation	6 Oil Field Water Supply	10 <input checked="" type="radio"/> Monitoring Well
3 Feedlot	7 Domestic (Lawn & Garden)	11 Injection Well
4 Industrial	8 Air Conditioning	12 Other .....

Was a chemical / bacteriological sample submitted to Department? Yes ..... No  X  
 If yes, mo/day/yr sample was submitted .....

Water Well Disinfected: Yes ..... No  X

5 TYPE OF BLANK CASING USED:

1 Steel	3 RMP (SR)	5 Wrought	7 Fiberglass	9 Other (Specify below)
2 <input checked="" type="radio"/> PVC	4 ABS	6 Asbestos-Cement	8 Concrete Tile	

Blank casing diameter 2 in. Was casing pulled? Yes  X No ..... If yes, how much 15'  
 Casing height above or below land surface Flush mount in.

6 GROUT PLUG MATERIAL: 1 Neat cement 2 Cement grout 3  Bentonite 4 Other .....

Grout Plug Intervals: From 15 ft. to 3 ft., From ..... ft. to ..... ft., From ..... to ..... ft.

What is the nearest source of possible contamination:

1 Septic tank	6 Seepage pit	11 <input checked="" type="radio"/> Fuel storage	16 Other (specify below)
2 Sewer lines	7 Pit privy	12 Fertilizer storage	
3 Watertight sewer lines	8 Sewage lagoon	13 Insecticide storage	
4 Lateral lines	9 Feedyard	14 Abandoned water well	
5 Cess pool	10 Livestock pens	15 Oil well/Gas well	

Direction from well? SE How many feet? 25'

FROM	TO	PLUGGING MATERIALS
<u>15'</u>	<u>3'</u>	<u>Bentonite grout</u>
<u>3'</u>	<u>1'</u>	<u>Bentonite chips / soil</u>
<u>1'</u>	<u>Surface</u>	<u>Cement</u>

7 CONTRACTOR'S OR LANDOWNER'S CERTIFICATION: This water well was plugged under my jurisdiction and was completed on (mo/day/year) Dec. 12, 2005 and this record is true to the best of my knowledge and belief. Kansas Water Well Contractor's License No. 710 This Water Well Record was completed on (mo/day/year) ..... under the business name of Below Ground Surface, Inc by (signature) [Signature]

INSTRUCTIONS: Use typewriter or ball point pen. Please press firmly and print clearly. Please fill in blanks, underline or circle the correct answers. Send top three copies to Kansas Department of Health and Environment, Bureau of Water, Geology Section, 1000 SW Jackson St., Ste. 420, Topeka, Kansas 66612-1367. Telephone: 785/296-5522. Send one to Water Well Owner and retain one for your records.