


1 LOCATION OF WATER WELL: Fraction 23' 9" of N.E. corner Section Number 7 Township Number T 32 S Range Number R 16 E
 County: MONTGOMERY NW 1/4 NW 1/4 Lot S.W 1/4

Distance and direction from nearest town or city street address of well if located within city?

INDEPENDENCE, KS INDEPENDENCE 2 miles North of town

2 WATER WELL OWNER: JUSTIN MYERS
 RR#, St. Address, Box #: RR #4 Board of Agriculture, Division of Water Resources
 City, State, ZIP Code: INDEPENDENCE, KS. 67301 Application Number:

3 LOCATE WELL'S LOCATION WITH AN "X" IN SECTION BOX:

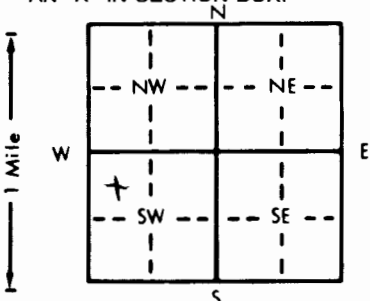

4 DEPTH OF COMPLETED WELL: 150 ft. ELEVATION:

Depth(s) Groundwater Encountered 1. 80 ft. 2. 130 ft. 3. 150 ft.

WELL'S STATIC WATER LEVEL: 40 ft. below land surface measured on mo/day/yr 4-24-84

Pump test data: Well water was _____ ft. after _____ hours pumping _____ gpm

Est. Yield 3 gpm: Well water was _____ ft. after _____ hours pumping _____ gpm

Bore Hole Diameter 9 in. to 20 ft., and 6 in. to 150 ft.

WELL WATER TO BE USED AS: 5 Public water supply 8 Air conditioning 11 Injection well

Domestic 3 Feedlot 6 Oil field water supply 9 Dewatering 12 Other (Specify below)

2 Irrigation 4 Industrial 7 Lawn and garden only 10 Observation well

Was a chemical/bacteriological sample submitted to Department? Yes _____ No X; If yes, mo/day/yr sample was sub-

mitted Water Well Disinfected? Yes X No

5 TYPE OF BLANK CASING USED: 5 Wrought iron 8 Concrete tile CASING JOINTS: Glued X Clamped

1 Steel 3 RMP (SR) 6 Asbestos-Cement 9 Other (specify below) Welded

X 2 PVC 4 ABS 7 Fiberglass Threaded

Blank casing diameter 6 in. to 20 ft., Dia. _____ in. to _____ ft., Dia. _____ in. to _____ ft.

Casing height above land surface 12 in., weight 180 lbs./ft. Wall thickness or gauge No. 1/4"

TYPE OF SCREEN OR PERFORATION MATERIAL: 7 PVC 10 Asbestos-cement

1 Steel 3 Stainless steel 5 Fiberglass 8 RMP (SR) 11 Other (specify)

2 Brass 4 Galvanized steel 6 Concrete tile 9 ABS X 12 None used (open hole)

SCREEN OR PERFORATION OPENINGS ARE: 5 Gauzed wrapped 8 Saw cut 11 None (open hole)

1 Continuous slot 3 Mill slot 6 Wire wrapped 9 Drilled holes

2 Louvered shutter 4 Key punched 7 Torch cut 10 Other (specify)

SCREEN-PERFORATED INTERVALS: From _____ ft. to _____ ft., From _____ ft. to _____ ft.

From _____ ft. to _____ ft., From _____ ft. to _____ ft.

GRAVEL PACK INTERVALS: From NONE ft. to _____ ft., From _____ ft. to _____ ft.

From _____ ft. to _____ ft., From _____ ft. to _____ ft.

6 GROUT MATERIAL: 1 Neat cement 2 Cement grout 3 Bentonite 4 Other

Grout Intervals: From 0 ft. to 20 ft., From _____ ft. to _____ ft., From _____ ft. to _____ ft.

What is the nearest source of possible contamination: 200'

Septic tank 4 Lateral lines 7 Pit privy 10 Livestock pens 14 Abandoned water well

2 Sewer lines 5 Cess pool 8 Sewage lagoon 11 Fuel storage 15 Oil well/Gas well

3 Watertight sewer lines 6 Seepage pit 9 Feedyard 12 Fertilizer storage 16 Other (specify below)

13 Insecticide storage

Direction from well? X EAST of well How many feet? 200'

FROM TO LITHOLOGIC LOG FROM TO LITHOLOGIC LOG

0 2 of soil

2 30 23 SANDSTONE

30 60 19 BLACK SHALE

60 85 20 LIME STONE

85 130 19 SHALE

130 131 05 WHITE SAND WATER

131 150 19 GRAY SHALE

7 CONTRACTOR'S OR LANDOWNER'S CERTIFICATION: This water well was (1) constructed, (2) reconstructed, or (3) plugged under my jurisdiction and was completed on (mo/day/year) 4-23-84 and this record is true to the best of my knowledge and belief. Kansas

Water Well Contractor's License No. 454 This Water Well Record was completed on (mo/day/yr) 5-6-84

under the business name of Gene's Water Well Service by (signature) Arnold C. Bellinger

INSTRUCTIONS: Use typewriter or ball point pen, PLEASE PRESS FIRMLY and PRINT clearly. Please fill in blanks, underline or circle the correct answers. Send top

three copies to Kansas Department of Health and Environment, Division of Environment, Environmental Geology Section, Topeka, KS 66620. Send one to WATER WELL

OWNER and retain one for your records.

DP