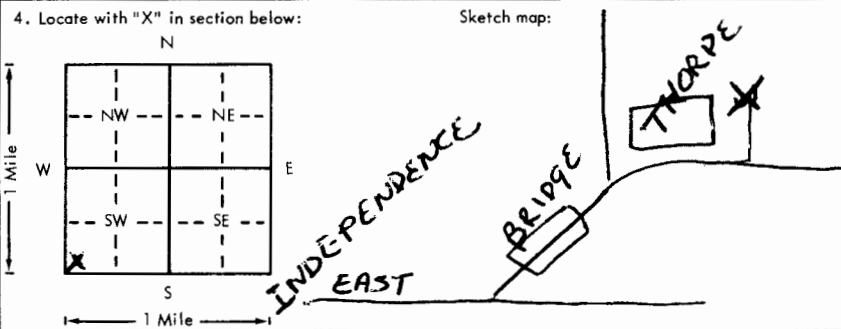


USE TYPEWRITER OR BALL
POINT PEN-PRESS FIRMLY,
PRINT CLEARLY.

WATER WELL RECORD
KSA 82a-1201-1215

Kansas Department of Health and
Environment-Division of Environment
(Water well Contractors)
Topeka, Kansas 66620

1. Location of well:		County MONTGOMERY	Fraction SW 1/4 SW 1/4 SW 1/4	Section number 28	Township number T 32	Range number S R 16	EDN
2. Distance and direction from nearest town or city:		E OF INDEPENDENCE		3. Owner of well: DONALD THORPE			
Street address of well location if in city:		BRIDGE 1/4 MI ON NORTH SIDE		R.R. or street: RR. #1			
				City, state, zip code: INDEPENDENCE KS. 67301			
4. Locate with "X" in section below:		Sketch map:		6. Bore hole dia 8 7/8 in. Completion date 4/9/79 Well depth 80 ft.			
				7. <input type="checkbox"/> Cable tool <input checked="" type="checkbox"/> Rotary <input type="checkbox"/> Driven <input type="checkbox"/> Dug <input type="checkbox"/> Hollow rod <input type="checkbox"/> Jetted <input type="checkbox"/> Bored <input type="checkbox"/> Reverse rotary			
5. Type and color of material		From		To		8. Use: <input checked="" type="checkbox"/> Domestic <input type="checkbox"/> Public supply <input type="checkbox"/> Industry <input type="checkbox"/> Irrigation <input type="checkbox"/> Air conditioning <input type="checkbox"/> Stock <input type="checkbox"/> Lawn <input type="checkbox"/> Oil field water <input type="checkbox"/> Other	
TOP SOIL		0		2		9. Casing: Material PVC Height: Above or below Threaded <input type="checkbox"/> Welded <input type="checkbox"/> Surface 18 in. RMP <input type="checkbox"/> PVC GLUE Weight <input type="checkbox"/> lbs./ft. Dia. 5 in. to 70 ft. depth Wall Thickness: inches or Dia. <input type="checkbox"/> in. to <input type="checkbox"/> ft. depth gage No. 258	
BROWN SILT		2		30		10. Screen: Manufacturer's name API Type PVC Dia. 5" Slot/gauze 25/1000 Length 90 Set between 70 ft. and 80 ft. <input type="checkbox"/> ft. and <input type="checkbox"/> ft. Gravel pack? YES Size range of material 1/2	
SHALE GRAY		33		80		11. Static water level: <input type="checkbox"/> mo./day/yr. 25 ft. below land surface Date 4/9/79	
						12. Pumping level below land surfaces: _____ ft. after _____ hrs. pumping _____ g.p.m. _____ ft. after _____ hrs. pumping _____ g.p.m. Estimated maximum yield 15 g.p.m.	
						13. Water sample submitted: <input type="checkbox"/> Yes <input checked="" type="checkbox"/> No Date 4/9/79 CAPI <input type="checkbox"/> mp./day/yr.	
						14. Well head completion: 18 inches above grade <input type="checkbox"/> Pitless adapter	
						15. Well grouted? <input checked="" type="checkbox"/> With: <input checked="" type="checkbox"/> Neat cement <input type="checkbox"/> Bentonite <input type="checkbox"/> Concrete Depth: From 0 ft. to 10 ft.	
						16. Nearest source of possible contamination: RIVER ft. 2000 Direction W Type _____ Well disinfected upon completion? <input checked="" type="checkbox"/> Yes <input type="checkbox"/> No	
						17. Pump: <input checked="" type="checkbox"/> Not installed Manufacturer's name _____ Model number _____ HP _____ Volts _____ Length of drop pipe _____ ft. capacity _____ g.p.m. Type: _____ <input type="checkbox"/> Submersible <input type="checkbox"/> Turbine <input type="checkbox"/> Jet <input type="checkbox"/> Reciprocating <input type="checkbox"/> Centrifugal <input type="checkbox"/> Other	
						20. Water well contractor's certification: This well was drilled under my jurisdiction and this report is true to the best of my knowledge and belief. Prewitt Const. 353 Business name Box 544 License No. _____ Address Antioch, Mo Signed _____ Date 4-9-79 Authorized representative	
18. Elevation:		19. Remarks:					
Topography: <input type="checkbox"/> Hill <input checked="" type="checkbox"/> Slope <input checked="" type="checkbox"/> Upland <input type="checkbox"/> Valley							

Forward the white, blue and pink copies to the Department of Health and Environment

Form WWC-5