


WATER WELL PLUGGING RECORD Form WWC-5P KSA 82a-1212 ID NO.

1. **LOCATION OF WATER WELL:** Fraction SW 1/4 NE 1/4 SW 1/4 SW 1/4 Section Number 30 Township Number T 32 S Range Number 16 E W
 County: MONTGOMERY

Street/Rural Address of Well Location; if unknown, distance & direction from nearest town or intersection: If at owner's address, check here
SOUTHWEST CORNER OF DINE ST & N. PENNSYLVANIA AVE

Global Positioning Systems (GPS) information:
 Latitude: 37.229025 (in decimal degrees)
 Longitude: -95.706758 (in decimal degrees)
 Elevation: 784.46
 Datum: WGS84, NAD83, NAD27
 Collection Method:
 GPS unit (Make/Model: _____)
 Digital Map/Photo, Topographic Map, Land Survey
 Est. Accuracy: < 3 m, 3-5 m, 5-15 m, > 15 m

2. **WATER WELL OWNER:** KOHE-DRTF
 RR#, St. Address, Box #: 1000 SW JACKSON, STE 410
 City, State ZIP Code: TOPEKA, KS 66612

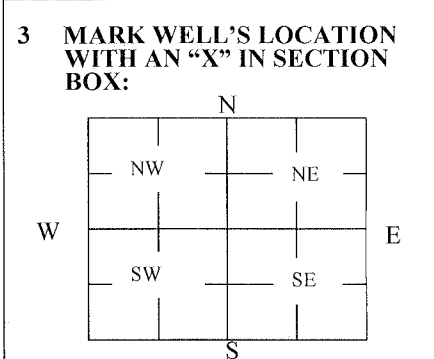

4. **DEPTH OF WELL** 5.55 ft.
 WELL'S STATIC WATER LEVEL dry ft
 WELL WAS USED AS:
 Domestic Public Water Supply Dewatering
 Irrigation Oil Field Water Supply Monitoring DCMW-4
 Feedlot Domestic (Lawn & Garden) Injection Well
 Industrial Air Conditioning Other _____
 Was a chemical/bacteriological sample submitted to Department? Yes No

5. **TYPE OF BLANK CASING USED:**
 Steel RMP (SR) Wrought Fiberglass Other (Specify below)
 PVC ABS Asbestos-Cement Concrete Tile
 Blank casing diameter 2 in. Was casing pulled? Yes No If yes, how much 5.55 (all)
 Casing height above or below land surface _____ in.

6. **GROUT PLUG MATERIAL:** Neat cement Cement grout Bentonite Other _____
 Grout Plug Intervals: From 5.55 ft. to 3 ft., From _____ ft. to _____ ft., From _____ ft. to _____ ft.
 What is the nearest source of possible contamination:
 Septic tank Seepage pit Fuel storage Other (specify below)
 Sewer lines Pit privy Fertilizer storage
 Watertight sewer lines Sewage lagoon Insecticide storage
 Lateral lines Feedyard Abandoned water well Direction from well? _____
 Cess pool Livestock pens Oil well/Gas well How many feet? _____

FROM	TO	PLUGGING MATERIALS	FROM	TO	PLUGGING MATERIALS
<u>5.55</u>	<u>3</u>	<u>BENTONITE</u>			
<u>3</u>	<u>0</u>	<u>NATIVE SOIL</u>			

7. **CONTRACTOR'S OR LANDOWNER'S CERTIFICATION:** This water well was plugged under my jurisdiction and was completed on (mo/day/year) 10/17/2013 and this record is true to the best of my knowledge and belief. Kansas Water Well Contractor's License No. _____. This Water Well Record was completed on (mo/day/year) 10/22/13 under the business name of KOHE-DRTF by (signature) [Signature] P.6.

INSTRUCTIONS: Use typewriter or ballpoint pen. Please press firmly and print clearly. Please fill in blanks, underline or circle the correct answers. Send top three copies to Kansas Department of Health and Environment, Bureau of Water, Geology Section, 1000 SW Jackson St., Ste. 420, Topeka, Kansas 66612-1367. Telephone: 785/296-5524. Send one to Water Well Owner and retain one for your records. Visit us at <http://www.kdheks.gov/waterwell/index.html>.

MEMORANDUM

To: Richard Harper, Bureau of Water, Water Well Section Chief

From: ^{JD} Joseph Dom, P.G., Superfund / Drycleaning Program Unit Manager

CC: File; Verdigris Laundry Center, 118 West Locust, Independence KS; C3-063-71776 (1)

Date: October 22, 2013

RE: DFRTF Monitoring Well Abandonment

The Kansas Drycleaning Program has abandoned the groundwater monitoring well (DCMW-4) located at the southwest corner of the intersection of Pine St. and N. Pennsylvania in Independence, KS. The monitoring well has been dry since the installation in 2011. The Drycleaning Program elected to abandon the monitoring well after the surface completion was compromised by sidewalk construction activities completed by the City of Independence. Enclosed with this memorandum are three copies of the completed WWC-5P Water Well Plugging Record for the monitoring well abandonment. Additional documentation of the well plugging activities can be located in the site file.

If you have any comments, questions or concerns, please feel free to contact me at 6-4367 or at jdom@kdheks.gov.

*Send to KGS
per Richard H.
10/25/13
Deb*

RECEIVED
OCT 22 2013
BUREAU OF WATER