

## WATER WELL PLUGGING RECORD Form WWC-5P

KSA 82a-1212

ID NO.

1 LOCATION OF WATER WELL: Fraction  $\frac{1}{4}$  SW  $\frac{1}{4}$  SE  $\frac{1}{4}$  Section Number 6 Township Number 32 Range Number 16 E W

Distance and direction from nearest town or city street address of well if located within city?

Approximately 1.75 North of Independence on Hwy 75 N. thence east on CR 5200 .5 mile. thence North on CR 3950 approximately .18 mile on east side

## 2 WATER WELL OWNER:

JEFFREY C. PASSAUER

RR#, St. Address, Box #:

5218 CR 3950

City, State ZIP Code:

INDEPENDENCE, KANSAS 67301

Global Positioning Systems (decimal degrees, min. of 4 digits)

Latitude: \_\_\_\_\_


Longitude: \_\_\_\_\_

Elevation: \_\_\_\_\_

Datum: \_\_\_\_\_

Data Collection Method: \_\_\_\_\_

## 3 MARK WELL'S LOCATION WITH AN "X" IN SECTION BOX:

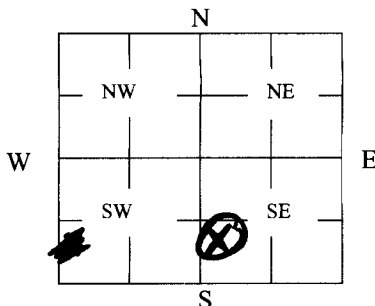

## 4 DEPTH OF WELL 48 ft.

WELL'S STATIC WATER LEVEL 33 ft

WELL WAS USED AS:

- 1 Domestic  
2 Irrigation  
3 Feedlot  
4 Industrial

- 5 Public Water Supply  
6 Oil Field Water Supply  
7 Domestic (Lawn & Garden)  
8 Air Conditioning

- 9 Dewatering  
10 Monitoring  
11 Injection Well  
12 Other \_\_\_\_\_

Was a chemical/bacteriological sample submitted to Department? Yes \_\_\_\_\_ No ☒

## 5 TYPE OF BLANK CASING USED:

- 1 Steel  
2 PVC

- 3 RMP (SR)  
4 ABS

- 5 Wrought  
6 Asbestos-Cement

- 7 Fiberglass  
8 Concrete Tile

9 Other (Specify below) \_\_\_\_\_

Blank casing diameter 8 in. Was casing pulled? Yes \_\_\_\_\_ No ☒ If yes, how much \_\_\_\_\_

Casing height above or below land surface 48 in.

## 6 GROUT PLUG MATERIAL:

1 Neat cement

2 Cement grout

3 Bentonite

4 Other \_\_\_\_\_

Grout Plug Intervals: From 30' ft. to 4' ft., From \_\_\_\_\_ ft. to \_\_\_\_\_ ft., From \_\_\_\_\_ to \_\_\_\_\_ ft.

What is the nearest source of possible contamination:

1 Septic tank

6 Seepage pit

11 Fuel Storage

16 Other (specify below) \_\_\_\_\_

2 Sewer lines

7 Pit privy

12 Fertilizer storage

3 Watertight sewer lines

8 Sewage lagoon

13 Insecticide storage

4 Lateral lines

9 Feedyard

14 Abandoned water well

Direction from well? SOUTH

5 Cess pool

10 Livestock pens

15 Oil well/Gas well

How many feet? 25'

FROM	TO	PLUGGING MATERIALS	FROM	TO	PLUGGING MATERIALS
48'	33'	Chlorinated Gravel			
33'	30'	CLAY			
30'	4'	NEAT CEMENT GROUT			
4'	0'	REMOVED CASING w/ SOIL COMPACTION			

7 CONTRACTOR'S OR LANDOWNER'S CERTIFICATION: This water well was plugged under my jurisdiction and was completed on (mo/day/year) 11/13/2015 and this record is true to the best of my knowledge and belief. Kansas Water Well Contractor's License No. LANDOWNER. This Water Well Record was completed on (mo/day/year) 11/13/2015 under the business name of by (signature) Jeff Passauer

INSTRUCTIONS: Use typewriter or ballpoint pen. Please press firmly and print clearly. Please fill in blanks, underline or circle the correct answers. Send top three copies to Kansas Department of Health and Environment, Bureau of Water, Geology Section, 1000 SW Jackson St., Ste. 420, Topeka, Kansas 66612-1367. Telephone: 785/296-5522. Send one to Water Well Owner and retain one for your records. Visit us at <http://www.kdheks.gov/geo/waterwells>.