

<b>1 LOCATION OF WATER WELL:</b> County: Montgomery	Fraction NE¼ SE¼ NW¼ SW¼	Section Number 30	Township Number T 32 S	Range Number 16 <input checked="" type="checkbox"/> E <input type="checkbox"/> W
--	-----------------------------	----------------------	---------------------------	---

Street/Rural Address of Well Location; if unknown, distance & direction from nearest town or intersection: If at owner's address, check here ☐  
~50' south of 1401 N Penn, Independence KS

**Global Positioning Systems (GPS) information:**

Latitude: NA (in decimal degrees)

Longitude: NA (in decimal degrees)

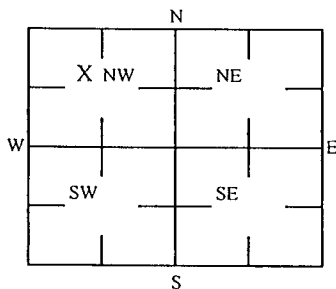
Elevation: NA

Horizontal Datum ☐ WGS84, ☐ NAD83, ☐ NAD27

Collection Method:

☐ GPS unit (Make/model: \_\_\_\_\_)☐ Digital Map/Photo, ☐ Topographic Map ☐ Land SurveyEst. Accuracy: ☐ <3 m, ☐ 3-5 m, ☐ 5-15 m, ☐ >15 m

**2 WATER WELL OWNER:** KDHE (Kendricks)  
RR#, 1000 SW Jackson  
City, State ZIP Code: Topeka, KS 66612

**3 MARK WELL'S LOCATION WITH AN "X" IN SECTION BOX:****4 DEPTH OF WELL** 14.31 ft. MW8

WELL'S STATIC WATER LEVEL \_\_\_\_\_ ft

WELL WAS USED AS:

☐ Domestic  
☐ Irrigation  
☐ Feedlot  
☐ Industrial

☐ Public Water Supply  
☐ Oil Field Water Supply  
☐ Domestic (Lawn & Garden)  
☐ Air Conditioning

☐ Dewatering  
☒ Monitoring  
☐ Injection Well  
☐ Other \_\_\_\_\_

Was a chemical/bacteriological sample submitted to Department?

Yes ☐ No ☒**5 TYPE OF BLANK CASING USED:**
☐ Steel  
☒ PVC

☐ RMP (SR)  
☐ ABS

☐ Wrought  
☐ Asbestos-Cement

☐ Fiberglass  
☐ Concrete Tile
☐ Other (Specific below) \_\_\_\_\_

Blank casing diameter 2 in.

Was casing pulled? Yes ☒ No ☐

If yes, how much 3'

Casing height above or below land surface NA in.

**6 GROUT PLUG MATERIAL:**☐ Neat cement☐ Cement grout☒ Bentonite☒ Other Asphalt: 0-0.5'

Grout Plug Intervals: From 0.5 ft to 14.31 ft, From \_\_\_\_\_ ft to \_\_\_\_\_ ft, From \_\_\_\_\_ ft to \_\_\_\_\_ ft,

What is the nearest source of possible contamination:

☐ Septic tank  
☐ Sewer lines  
☐ Watertight sewer lines  
☐ Lateral lines  
☐ Cess pool

☐ Seepage pit  
☐ Pit privy  
☐ Sewage lagoon  
☐ Feed yard  
☐ Livestock pens

☒ Fuel storage  
☐ Fertilizer storage  
☐ Insecticide storage  
☐ Abandoned water well  
☐ Oil well/Gas well
☐ Other (specify below) \_\_\_\_\_

Direction from well? \_\_\_\_\_

How many feet? \_\_\_\_\_

FROM	TO	PLUGGING MATERIALS	FROM	TO	PLUGGING MATERIALS
0	0.5	Asphalt			
0.5	14.31	Bentonite			

KDHE ID: Kendricks Service; U3-063-00423

**7 CONTRACTOR'S OR LANDOWNER'S CERTIFICATION:**

This water well was plugged under my jurisdiction and was completed on (mo/day/year) 7/30-31/19 and this record is true to the best of my knowledge and belief. Kansas Water Contractor's License No. 757. This Water Well Record was completed on (mo/day/year) 8/1/19 under the business name of Larsen & Associates, Inc. By (signature) \_\_\_\_\_

Send one white copy to Kansas Department of Health & Environment, Geology Section, 1000 SW Jackson Street, Ste. 420, Topeka, KS 66612-1367. Send one copy to WATER WELL OWNER and retain one for your records  
Visit us at <http://www.kdheks.gov/waterwell/index.html> Telephone 785-296-5524.