WATER WELL PLUGGING RECORD Form WWC-5P KSA 82a-1212 ID NO. MW10

1 LOCATION OF WATER WELL: County: Montgomery | Fraction: NE¼ SE¼ NW¼ NW¼ | Section Number: 30 | Township Number: T 32 S | Range Number: 16 [X] E [ ] W

Street/Rural Address of Well Location; if unknown, distance & direction from nearest town or intersection: If at owner's address, check here [ ]
1401 N Penn, Independence KS

Global Positioning Systems (GPS) information:
Latitude: NA (in decimal degrees)
Longitude: NA (in decimal degrees)
Elevation: NA
Horizontal Datum [ ] WGS84, [ ] NAD83, [ ] NAD27
Collection Method:
[ ] GPS unit (Make/model: ____)
[ ] Digital Map/Photo, [ ] Topographic Map [ ] Land Survey
Est. Accuracy: [ ] <3 m, [ ] 3-5 m, [ ] 5-15 m, [ ] >15 m

2 WATER WELL OWNER: KDHE (Kendricks)
RR#, 1000 SW Jackson
City, State ZIP Code: Topeka, KS 66612

3 MARK WELL'S LOCATION WITH AN "X" IN SECTION BOX:

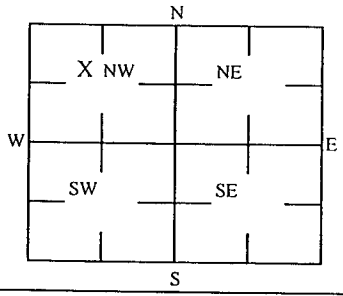

4 DEPTH OF WELL 14.95 ft. MW10

WELL'S STATIC WATER LEVEL ____ ft

WELL WAS USED AS:

[ ] Domestic	[ ] Public Water Supply	[ ] Dewatering
[ ] Irrigation	[ ] Oil Field Water Supply	[X] Monitoring
[ ] Feedlot	[ ] Domestic (Lawn & Garden)	[ ] Injetion Well
[ ] Industrial	[ ] Air Conditioning	[ ] Other ____

Was a chemical/bacteriological sample submitted to Department? Yes [ ] No [X]

5 TYPE OF BLANK CASING USED:

[ ] Steel	[ ] RMP (SR)	[ ] Wrought	[ ] Fiberglass	[ ] Other (Specific below)
[X] PVC	[ ] ABS	[ ] Asbestos-Cement	[ ] Concrete Tile	

Blank casing diameter 2 in. Was casing pulled? Yes [X] No [ ] If yes, how much 3'
Casing heigh above or below land surface NA in.

6 GROUT PLUG MATERIAL: [ ] Neat cement [ ] Cement grout [X] Bentonite [X] Other Concrete: 0-0.5'

Grout Plug Intervals: From 0.5 ft to 14.95 ft, From ____ ft to ____ ft, From ____ ft to ____ ft,

What is the nearest source of possible contamination:

[ ] Septic tank	[ ] Seepage pit	[X] Fuel storage	[ ] Other (specify below)
[ ] Sewer lines	[ ] Pit privy	[ ] Fertilizer storage	
[ ] Watertight sewer lines	[ ] Sewage lagoon	[ ] Insecticide storage	
[ ] Lateral lines	[ ] Feed yard	[ ] Abandoned water well	Direction from well? ____
[ ] Cess pool	[ ] Livestock pens	[ ] Oil well/Gas well	How many feet? ____

FROM	TO	PLUGGING MATERIALS	FROM	TO	PLUGGING MATERIALS
0	0.5	Concrete			
0.5	14.95	Bentonite			
			KDHE ID: Kendricks Service; U3-063-00423		

7 CONTRACTOR'S OR LANDOWNER'S CERTIFICATION: This water well was plugged under my jurisdiction and was completed on (mo/day/year) 7/30-31/19 and this record is true to the best of my knowledge and belief. Kansas Water Contractor's License No. 757. This Water Well Record was completed on (mo/day/year) 8/13/19 under the business name of Larsen & Associates, Inc. By (signature) ____

Send one white copy to Kansas Department of Health & Environment, Geology Section, 1000 SW Jackson Street, Ste. 420, Topeka, KS 66612-1367. Send one copy to WATER WELL OWNER and retain one for your records
Visit us at http://www.kdheks.gov/waterwell/index.html Telephone 785-296-5524.