

WATER WELL RECORD

Form WWC-5

Division of Water Resources App. No.


Well ID

MW12

Original Record Correction Change in Well Ust

1 LOCATION OF WATER WELL: County Montgomery Fraction NE 1/4 SE 1/4 NE 1/4 NW 1/4 Section Number 31 Township Number T 32 S Range Number R 16 E W

2 WELL OWNER: Last Name: Shanks First: Jerry Street or Rural Address where well is located (if unknown, distance and direction from nearest town or intersection): 323 E Main, Independence, KS

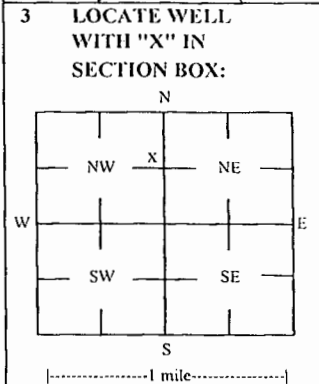

4 DEPTH OF COMPLETED WELL: 15 ft Depth(s) Groundwater Encountered: 1) 15 ft 2) ft 3) ft, or 4) Dry Well WELLS STATIC WATER LEVEL: NA ft

5 Latitude: 37.22310 (decimal degrees) Longitude: 95.70302 (decimal degrees) Horizontal Datum: WGS 84 NAD 83 NAD 27

6 Elevation: 814.66 ft Ground Level TOC Source: Land Survey GPS Topographic Map Other

7 WELL WATER TO BE USED AS: 1 Domestic: Household Lawn & Garden Livestock Irrigation Feedlot Industrial 2 Public Water Supply: well ID 3 Dewatering: how many wells? 4 Aquifer Recharge: well ID 5 Monitoring: well ID MW12 6 Environmental Remediation: well ID 7 Air Sparge Soil Vapor Extractor Recovery Injection 8 Oil Field Water Supply: lease 9 Test Hole: well ID 10 Cased Uncased Geotechnical 11 Geothermal: How many bores? 12 a) Closed Loop Horizontal Vertical b) Open Loop Surface Discharge Inj. of Water Other (specify):

Was a chemical/bacteriological sample submitted to KDHE? Yes No If yes, date sample was submitted: Water well disinfected? Yes No

8 TYPE OF CASING USED: Steel PVC Other CASING JOINTS: Glued Clamped Welded Threaded Casing diameter 2 in. to 5 ft, Diameter in. to ft, Casing height above land surface -0.37 in. Weight lbs./ft. Well thickness or gauge No

9 GROUT MATERIAL: Neat cement Cement grout Bentonite Other Concrete: 0-0.5' Grout intervals: From 0.5 ft. to 3 ft, From ft. to ft, From ft. to ft

Nearest source of possible contamination: Septic Tank Lateral Lines Pit Privy Livestock Pens Insecticide Storage Sewer Lines Cess Pool Sewage Lagoon Fuel Storage Abandoned Water Well Watertight Sewer Lines Seepage Pit Feedyard Fertilizer Storage Oil Well / Gas Well Other (Specify)

Table with columns: 10 FROM, TO, LITHOLOGIC LOG, FROM, TO, LITHO. LOG (cont.) or PLUGGING INTERVALS. Rows show depth intervals from 0 to 15.5 ft with lithology descriptions like Concrete, Sandy loam, and Shale.

Notes: KDHE ID: Eastside 66; U3-063-00369 Target of monitoring well is shallow groundwater, <20' of grout was installed at the direction of KDHE.

11 CONTRACTOR'S OR LANDOWNER'S CERTIFICATION: This water well was constructed, reconstructed, or plugged under my jurisdiction and was completed on (mo-day-year) 11/11/21 and this record is true to the best of my knowledge and belief.



- USTs
- Buildings
- Property Boundary
- GW Flow Direction
- Benchmark
- Well - Proposed
- Well - Sampled
- Well - Not Sampled
- Well - Gauge Only
- Well - Abandoned
- Product Line
- GW Flow Contours

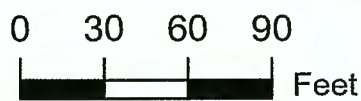


Figure 1
Proposed Well Locations
October 2021

Client: Eastside 66
323 E. Main Street
Independence
KDHE Site Code: U3-063-00369

