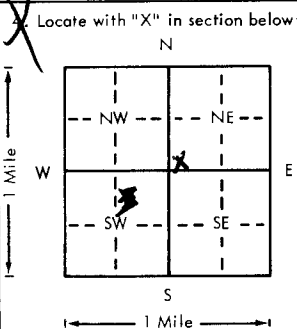


USE TYPEWRITER OR BALL  
POINT PEN-PRESS FIRMLY,  
PRINT CLEARLY.

WATER WELL RECORD  
KSA 82a-1201-1215

Kansas Department of Health and  
Environment-Division of Environment  
(Water well Contractors)  
Topeka, Kansas 66620

1. Location of well: County <u>MONTGOMERY</u> Fraction <u>SW SW NE</u> Section number <u>8</u> Township number <u>T 32</u> Range number <u>S 17 E 0</u>	
2. Distance and direction from nearest town or city: <u>CORNER OF</u> 3. Owner of well: <u>NATIONAL Zinc Co.</u>	
Street address of well location if in city: <u>MARTIN &amp; SCHOOL ST</u> R.R. or street: <u>CHERRYVALE, K.</u> City, state, zip code: <u>BOX 280 67335</u>	
4. Locate with "X" in section below: Sketch map: <u>Well test # B-1</u>	
	
5. Type and color of material	
From To	
<u>TOP SOIL &amp; GINDER = BLACK</u> 0 1	
<u>SILTY CLAY = YELLOW &amp; BROWN</u> 1 17	
6. Bore hole dia. <u>6</u> in. Completion date <u>4-26-78</u>	
Well depth <u>17</u> ft.	
7. <input checked="" type="checkbox"/> Cable tool <input type="checkbox"/> Rotary <input type="checkbox"/> Driven <input type="checkbox"/> Dug	
<input type="checkbox"/> Hollow rod <input type="checkbox"/> Jetted <input type="checkbox"/> Bored <input type="checkbox"/> Reverse rotary	
8. Use: <input type="checkbox"/> Domestic <input type="checkbox"/> Public supply <input type="checkbox"/> Industry	
<input type="checkbox"/> Irrigation <input type="checkbox"/> Air conditioning <input type="checkbox"/> Stock	
<input type="checkbox"/> Lawn <input type="checkbox"/> Oil field water <input checked="" type="checkbox"/> Other	
9. Casing: Material <u>P.V.C.</u> Height: <u>Above</u> or below	
Threaded <input type="checkbox"/> Welded <u>GL</u> Surface <u>6</u> in.	
RMP <input type="checkbox"/> PVC <input type="checkbox"/> Weight <input type="checkbox"/> lbs./ft.	
Dia. <u>3</u> in. to <u>9</u> ft. depth Wall Thickness: inches or	
Dia. <u>3</u> in. to <u>9</u> ft. depth gage No. <u>216</u>	
10. Screen: Manufacturer's name <u>M. P. I.</u>	
Type <u>P.V.C.</u> Dia. <u>3</u>	
Slot gauze <u>1/16</u> Length <u>8</u>	
Set between <u>9</u> ft. and <u>17</u> ft.	
<u>ft.</u> and <u>ft.</u>	
Gravel pack? <u>yes</u> Size range of material <u>5/0</u>	
11. Static water level: <u>8</u> ft. below land surface Date <u>4-26-78</u>	
ma./day/yr.	
12. Pumping level below land surfaces:	
<u>ft.</u> after <u>hrs.</u> pumping <u>g.p.m.</u>	
<u>ft.</u> after <u>hrs.</u> pumping <u>g.p.m.</u>	
Estimated maximum yield <u>g.p.m.</u>	
13. Water sample submitted: <u>Yes</u> <input checked="" type="checkbox"/> No <input type="checkbox"/> Date <u>4-26-78</u>	
ma./day/yr.	
14. Well head completion: <u>P.V.C. C.P.R.</u>	
<u>Pitless adapter</u> <u>6</u> inches above grade	
15. Well grouted? <u>yes</u>	
With: <input checked="" type="checkbox"/> Neat cement <input type="checkbox"/> Bentonite <input type="checkbox"/> Concrete	
Depth: From <u>0</u> ft. to <u>8</u> ft.	
16. Nearest source of possible contamination: <u>10</u> ft. Direction <u>NO</u> Type <u>Pond</u>	
Well disinfected upon completion? <input checked="" type="checkbox"/> Yes <input type="checkbox"/> No	
17. Pump: <input checked="" type="checkbox"/> Not installed	
Manufacturer's name <u>PRWI &amp; Const</u>	
Model number <u>353</u> HP <u>1/4</u> Volts <u>115</u>	
Length of drop pipe <u>ft.</u> capacity <u>g.p.m.</u>	
Type: <input type="checkbox"/> Submersible <input type="checkbox"/> Turbine	
<input type="checkbox"/> Jet <input type="checkbox"/> Reciprocating	
<input type="checkbox"/> Centrifugal <input type="checkbox"/> Other	
18. Elevation: 19. Remarks: <u>Test well for</u>	
<u>Pollution ground &amp; 8" gravel</u>	
<u>F.A. Hawkins</u>	
<u>Test well in Pond Dyke</u>	
20. Water well contractor's certification: This well was drilled under my jurisdiction and this report is true to the best of my knowledge and belief.	
Business name <u>PRWI &amp; Const</u> License No. <u>353</u>	
Address <u>Austin Street</u> Date <u>4/26</u>	
Signed <u>Austin Street</u> Authorized representative	

Forward the white, blue and pink copies to the Department of Health and Environment

Farm WWC-5