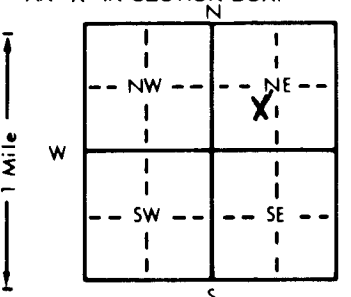


1 LOCATION OF WATER WELL: County: Montgomery		Fraction NE 1/4 SW 1/4 NE 1/4		Section Number 31	Township Number T 32 S	Range Number R 17 E EW	
Distance and direction from nearest town or city street address of well if located within city? 3 Miles South of Cherryvale, KS at Highways 96 & 169	
2 WATER WELL OWNER: Resource Recovery Inc. RR#, St. Address, Box #: 1801 Woodland City, State, ZIP Code: Coffeyville, KS 67337 Board of Agriculture, Division of Water Resources Application Number:	
3 LOCATE WELL'S LOCATION WITH AN "X" IN SECTION BOX: 		4 DEPTH OF COMPLETED WELL: 175 ft. ELEVATION: Depth(s) Groundwater Encountered 1. 999 ft. 2. ft. 3. ft. WELL'S STATIC WATER LEVEL 999 ft. below land surface measured on mo/day/yr Pump test data: Well water was ft. after hours pumping gpm Est. Yield gpm: Well water was ft. after hours pumping gpm Bore Hole Diameter in. to ft., and in. to ft. WELL WATER TO BE USED AS: 5 Public water supply 8 Air conditioning 11 Injection well 1 Domestic 3 Feedlot 6 Oil field water supply 9 Dewatering 12 Other (Specify below) MW-5 2 Irrigation 4 Industrial 7 Lawn and garden only 10 Monitoring well Was a chemical/bacteriological sample submitted to Department? Yes No X ; If yes, mo/day/yr sample was submitted Water Well Disinfected? Yes No X	
5 TYPE OF BLANK CASING USED: 1 Steel 3 RMP (SR) 5 Wrought iron 8 Concrete tile CASING JOINTS: Glued Clamped 2 PVC 4 ABS 6 Asbestos-Cement 9 Other (specify below) Welded 7 Fiberglass Threaded X Blank casing diameter 2 in. to 155 ft. Dia in. to ft. Dia in. to ft. Casing height above land surface 30 in. weight lbs./ft. Wall thickness or gauge No. Sch. 40 TYPE OF SCREEN OR PERFORATION MATERIAL: 1 Steel 3 Stainless steel 5 Fiberglass 8 RMP (SR) 10 Asbestos-cement 2 Brass 4 Galvanized steel 6 Concrete tile 9 ABS 11 Other (specify) 12 None used (open hole) SCREEN OR PERFORATION OPENINGS ARE: 1 Continuous slot 3 Mill slot 5 Gauzed wrapped 8 Saw cut 11 None (open hole) 2 Louvered shutter 4 Key punched 6 Wire wrapped 9 Drilled holes 7 Torch cut 10 Other (specify) Factory Slot SCREEN-PERFORATED INTERVALS: From 155 ft. to 175 ft. From ft. to ft. GRAVEL PACK INTERVALS: From 153 ft. to 176 ft. From ft. to ft. 6 GROUT MATERIAL: 1 Neat cement 2 Cement grout 3 Bentonite 4 Other Grout Intervals: From (2) 0 ft. to 150 ft. From (3) 150 ft. to 153 ft. From ft. to ft. What is the nearest source of possible contamination: 1 Septic tank 4 Lateral lines 7 Pit privy 10 Livestock pens 14 Abandoned water well 2 Sewer lines 5 Cess pool 8 Sewage lagoon 11 Fuel storage 15 Oil well/Gas well 3 Watertight sewer lines 6 Seepage pit 9 Feedyard 12 Fertilizer storage 16 Other (specify below) Unknown 13 Insecticide storage Direction from well? How many feet?	
<table border="1"><thead><tr><th>FROM</th><th>TO</th><th>LITHOLOGIC LOG</th><th>FROM</th><th>TO</th><th>PLUGGING INTERVALS</th></tr></thead><tbody><tr><td>0</td><td>0.3</td><td>Brown Clay</td><td></td><td></td><td></td></tr><tr><td>0.3</td><td>1.5</td><td>Red Brown-Yellow Tan Sandstone</td><td></td><td></td><td></td></tr><tr><td>1.5</td><td>7.5</td><td>Tan Sandstone</td><td></td><td></td><td></td></tr><tr><td>7.5</td><td>7.7</td><td>Dk. Gray Shale, Sandy</td><td></td><td></td><td></td></tr><tr><td>7.7</td><td>8.9</td><td>Tan Clay Shale</td><td></td><td></td><td></td></tr><tr><td>8.9</td><td>26.0</td><td>Tan & Gray Shale, Sandstone</td><td></td><td></td><td></td></tr><tr><td>26.0</td><td>31.5</td><td>Tan Sandstone</td><td></td><td></td><td></td></tr><tr><td>31.5</td><td>150.7</td><td>GRAY SHALE - Limestone</td><td></td><td></td><td></td></tr><tr><td>150.7</td><td>176.</td><td>Gray Sandy, Dark Gray Shale, Silty</td><td></td><td></td><td></td></tr>
7 CONTRACTOR'S OR LANDOWNER'S CERTIFICATION: This water well was (1) constructed (2) reconstructed, or (3) plugged under my jurisdiction and was completed on (mo/day/year) 4/26/93 and this record is true to the best of my knowledge and belief. Kansas Water Well Contractor's License No. 458 This Water Well Record was completed on (mo/day/yr) 4/26/93 under the business name of The Winnek Co., Inc. by (signature) <i>John W. Berlin</i>	
INSTRUCTIONS: Use typewriter or ball point pen. PLEASE PRESS FIRMLY and PRINT clearly. Please fill in blanks, underline or circle the correct answers. Send top three copies to Kansas Department of Health and Environment, Bureau of Water, Topeka, Kansas 66620-0001. Telephone: 913-296-5545. Send one to WATER WELL OWNER and retain one for your records.	