


1	LOCATION OF WATER WELL: Fraction	Section Number	Township Number	Range Number
County:	Montgomery NE ¼ NE ¼ NE ¼	17	32	17-East

Distance and direction from nearest town or city street address of well if located within city?

312 S. Liberty, Cherryvale, Kansas

2	WATER WELL OWNER: Crescent Oil Company	Board of Agriculture, Division of Water Resources
RR#, St. Address, Box #	1020 W. Sycamore Street	Application Number:
City, State, ZIP Code	Independence, Kansas 67301	

3 MARK WELL'S LOCATON WITH AN "X" IN SECTION BOX:

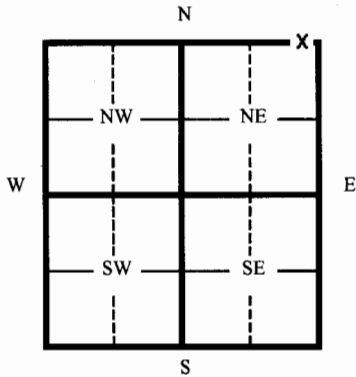

4	DEPTH OF WELL	13.5	ft.
	WELL'S STATIC WATER LEVEL	8.52	ft.
WELL WAS USED AS:			
1 Domestic	5 Public Water Supply	9 Dewatering	
2 Irrigation	6 Oil Field Water Supply	10 Monitoring Well	
3 Feedlot	7 Lawn and Garden (domestic)	11 Injection Well	
4 Industrial	8 Air Conditioning	12 Other	
Was a chemical/bacteriological sample submitted to Department? Yes ___ No X			
If yes, mo/day/yr sample was submitted _____			
Water Well Disinfected: Yes ___ No X			

5 TYPE OF BLANK CASING USED:

1 Steel	3 RMP (SR)	5 Wrought	7 Fiberglass	9 Other (specify below)
2 PVC	4 ABC	6 Asbestos-Cement	8 Concrete Tile	

Blank casing diameter **2.375** in. Was casing pulled? Yes ___ No **X** If yes, how much? **N/A**

Casing height above or below land surface **Unknown** in. **Casing plugged; casing removed to depth of 3' BTOC.**

6 GROUT PLUG MATERIAL: 1 Neat cement 2 Cement grout **3 Bentonite** **4 Other** **Soils/Concrete**

Grout Plug Intervals From **13.5** ft. to **3.0** ft. From **3.0** ft. to **1.0** ft. From **1.0** ft. to **0.0** ft.

What is the nearest source of possible contamination:

1 Septic tank	6 Seepage pit	11 Fuel storage	16 Other (specify below)
2 Sewer lines	7 Pit privy	12 Fertilizer storage	
3 Watertight sewer lines	8 Sewage lagoon	13 Insecticide storage	
4 Lateral lines	9 Feedyard	14 Abandoned water well	
5 Cess Pool	10 Livestock pens	15 Oil well/ Gas well	

Direction from well? **Northwest** How many feet? **60**

FROM	TO	CODE	PLUGGING MATERIALS
0.0	1.0		Concrete
1.0	3.0		Compacted Soils
3.0	13.5		Bentonite chips

7 CONTRACTOR'S OR LANDOWNER'S CERTIFICATION: This water well was plugged under my jurisdiction and was completed on (mo/day/yr) **10/17/07** and this record is true to the best of my knowledge and belief. Kansas Water Well Contractor's License No. **692** This Water Well Record was completed on (mo/day/yr) **10/19/07** under the business name of **Quad State Services, Inc.**

by (signature) *[Signature]*

INSTRUCTIONS: Please fill in blanks and circle the correct answers. Send three copies to Kansas Department of Health and Environment, Bureau of Water, 1000 S W Jackson St., Ste. 420, Topeka, Kansas 66620-0001. Telephone: 785-296-3565. Send one to Water Well Owner and retain one for your records.