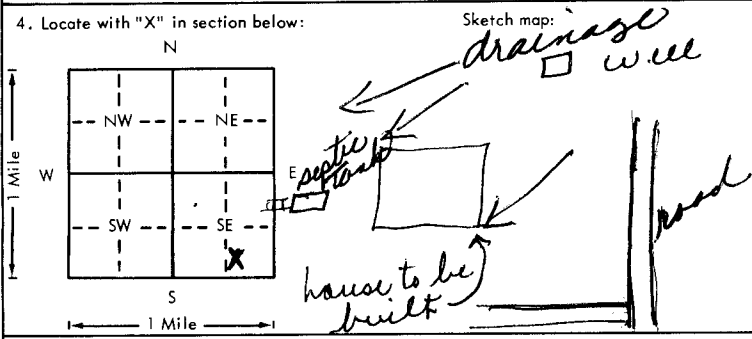


USE TYPEWRITER OR BALL
POINT PEN-PRESS FIRMLY,
PRINT CLEARLY.

WATER WELL RECORD
KSA 82a-1201-1215

Kansas Department of Health and
Environment-Division of Environment
(Water well Contractors)
Topeka, Kansas 66620

1. Location of well: County <u>Lafayette</u> Fraction <u>SE 1/4 SE 1/4 SW 1/4</u> Section number <u>6</u> Township number <u>T 32 S</u> Range number <u>R 18 E</u>			
2. Distance and direction from nearest town or city: <u>1 mile north</u> OR <u>Cherryvale, Mo. 5 1/2 ml. east</u>		3. Owner of well: <u>Ritchie Hanley</u> R.R. or street: <u>R#1</u> City, state, zip code: <u>Cherryvale, Ks. 67335</u>	
4. Locate with "X" in section below: 		6. Bore hole dia. <u>9.5</u> in. Completion date <u>8/25/78</u> Well depth <u>80</u> ft.	
5. Type and color of material		7. <input checked="" type="checkbox"/> Cable tool <input type="checkbox"/> Rotary <input type="checkbox"/> Driven <input type="checkbox"/> Dug <input type="checkbox"/> Hollow rod <input type="checkbox"/> Jetted <input type="checkbox"/> Bored <input type="checkbox"/> Reverse rotary	
From To		8. Use: <input checked="" type="checkbox"/> Domestic <input type="checkbox"/> Public supply <input type="checkbox"/> Industry <input type="checkbox"/> Irrigation <input type="checkbox"/> Air conditioning <input type="checkbox"/> Stock <input type="checkbox"/> Lawn <input type="checkbox"/> Oil field water <input type="checkbox"/> Other	
Topsoil 0 1		9. Casing: Material <u>PVC</u> Height <u>Above</u> or below Threaded <input type="checkbox"/> Welded <input type="checkbox"/> Surface <u>14</u> in. RMP <input type="checkbox"/> PVC <input checked="" type="checkbox"/> Weight <input type="checkbox"/> lbs./ft. Dia. <u>6</u> in. to <u>20</u> ft. depth Wall Thickness: inches or Dia. <input type="checkbox"/> in. to <input type="checkbox"/> ft. depth gage No. <u>3/16</u>	
Sandstone 1 18		10. Screen: Manufacturer's name <u>NONE USED</u> Type <input type="checkbox"/> Dia. <input type="checkbox"/> Slot/gouze <input type="checkbox"/> Length <input type="checkbox"/> Set between <input type="checkbox"/> ft. and <input type="checkbox"/> ft. <input type="checkbox"/> ft. and <input type="checkbox"/> ft. Gravel pack? <input type="checkbox"/> Size range of material <input type="checkbox"/>	
Shale 18 70		11. Static water level: <u>20</u> ft. below land surface Date <u>8/25/78</u> mo./day/yr.	
Limestone 70 80		12. Pumping level below land surfaces: <u>N.A.</u> <input type="checkbox"/> ft. after <input type="checkbox"/> hrs. pumping <input type="checkbox"/> g.p.m. <input type="checkbox"/> ft. after <input type="checkbox"/> hrs. pumping <input type="checkbox"/> g.p.m. Estimated maximum yield <input type="checkbox"/> g.p.m.	
		13. Water sample submitted: <input type="checkbox"/> Yes <input checked="" type="checkbox"/> No Date <input type="checkbox"/> mo./day/yr.	
		14. Well head completion: <input type="checkbox"/> Pitless adapter <input type="checkbox"/> Inches above grade	
		15. Well grouted? <u>YES</u> With: <input checked="" type="checkbox"/> Neat cement <input type="checkbox"/> Bentonite <input type="checkbox"/> Concrete Depth: From <u>Surface</u> ft. to <u>20</u> ft.	
Well has been capped		16. Nearest source of possible contamination: <u>NONE</u> ft. <u>NONE</u> Direction <input type="checkbox"/> Type <input type="checkbox"/> Well disinfected upon completion? <input type="checkbox"/> Yes <input checked="" type="checkbox"/> No	
Owner will disinfect his own		17. Pump: <input checked="" type="checkbox"/> Not installed	
well as soon as house is		Manufacturer's name <input type="checkbox"/>	
complete. He will also take		Model number <input type="checkbox"/> HP <input type="checkbox"/> Volts <input type="checkbox"/>	
sample of water for testing.		Length of drop pipe <input type="checkbox"/> ft. capacity <input type="checkbox"/> g.p.m.	
(Use a second sheet if needed)		Type: <input type="checkbox"/> Submersible <input type="checkbox"/> Turbine <input type="checkbox"/> Jet <input type="checkbox"/> Reciprocating <input type="checkbox"/> Centrifugal <input type="checkbox"/> Other	
18. Elevation:	19. Remarks: <u>Concrete slab to be installed</u> <u>by owner of well at ground</u> <u>surface. He knows this is a</u> <u>regulation.</u> <u>Ritchie Hanley</u>		20. Water well contractor's certification: This well was drilled under my jurisdiction and this report is true to the best of my knowledge and belief. <u>Bills Water Well Drilling 366</u> Business name <u>BI Thayer, Ks. 66776</u> License No. <u>1/4 SE SE 1/4</u> Address <u>Bill Thayer</u> Signed <u>Bill Thayer</u> Date <u>8/25/78</u> Authorized representative

Forward the white, blue and pink copies to the Department of Health and Environment

Form WWC-5