


1 LOCATION OF WATER WELL: Fraction NE 1/4 SE 1/4 Section Number 5 Township Number T 32 S Range Number R 2E E/W  
 County: SUMNER

Distance and direction from nearest town or city street address of well if located within city?  
4 MILES WEST OF WARDON ON HIGHWAY 160 MW25

2 WATER WELL OWNER: McCONNELL AFB C/O TETRA TECH INC.  
 RR#, St. Address, Box #: 10 E. CAMBRIDGE CIR. DR., STE 130  
 City, State, ZIP Code: KANSAS CITY, KS 66103  
 Board of Agriculture, Division of Water Resources  
 Application Number:

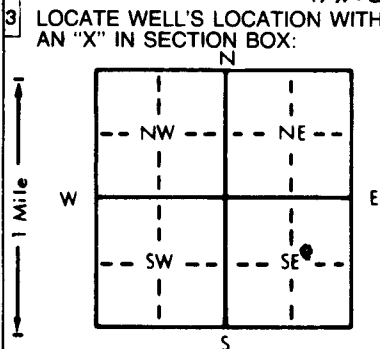

4 DEPTH OF COMPLETED WELL: 40.0 ft. ELEVATION: .....  
 Depth(s) Groundwater Encountered 1. 25.0 ft. 2. .... ft. 3. .... ft.  
 WELL'S STATIC WATER LEVEL: 25 ft. below land surface measured on mo/day/yr .....  
 Pump test data: Well water was ..... ft. after ..... hours pumping ..... gpm  
 Est. Yield ..... gpm: Well water was ..... ft. after ..... hours pumping ..... gpm  
 Bore Hole Diameter: 8.75 in. to 40.0 ft., and ..... in. to ..... ft.  
 WELL WATER TO BE USED AS:  
 5 Public water supply 8 Air conditioning 11 Injection well  
 1 Domestic 3 Feedlot 6 Oil field water supply 9 Dewatering 10 Other (Specify below)  
 2 Irrigation 4 Industrial 7 Lawn and garden only 10 Monitoring well SOIL BORING  
 Was a chemical/bacteriological sample submitted to Department? Yes.....No.....; If yes, mo/day/yr sample was submitted  
 Water Well Disinfected? Yes No

5 TYPE OF BLANK CASING USED:  
 1 Steel 3 RMP (SR) 5 Wrought iron 8 Concrete tile CASING JOINTS: Glued ..... Clamped .....  
 2 PVC 4 ABS 7 Fiberglass 9 Other (specify below) Welded .....  
 Blank casing diameter: 9 in. to 25.2 ft., Dia. .... in. to ..... ft., Dia. .... in. to ..... ft.  
 Casing height above land surface: 0 in., weight ..... lbs./ft. Wall thickness or gauge No. Sch. 40  
 TYPE OF SCREEN OR PERFORATION MATERIAL:  
 1 Steel 3 Stainless steel 5 Fiberglass 8 RMP (SR) 10 Asbestos-cement  
 2 Brass 4 Galvanized steel 6 Concrete tile 9 ABS 11 Other (specify) .....  
 SCREEN OR PERFORATION OPENINGS ARE:  
 1 Continuous slot 3 Mill slot 5 Gauzed wrapped 8 Saw cut 11 None (open hole)  
 2 Louvered shutter 4 Key punched 6 Wire wrapped 9 Drilled holes  
 7 Torch cut 10 Other (specify) .....  
 SCREEN-PERFORATED INTERVALS: From 25.2 ft. to 35.2 ft., From ..... ft. to ..... ft.  
 GRAVEL PACK INTERVALS: From 23.0 ft. to 40.0 ft., From ..... ft. to ..... ft.

6 GROUT MATERIAL: 1 Neat cement 2 Cement grout 3 Bentonite 4 Other .....  
 Grout Intervals: From 0.0 ft. to 18.0 ft., From 18.0 ft. to 23.0 ft., From ..... ft. to ..... ft.  
 What is the nearest source of possible contamination:  
 1 Septic tank 4 Lateral lines 7 Pit privy 10 Livestock pens 14 Abandoned water well  
 2 Sewer lines 5 Cess pool 8 Sewage lagoon 11 Fuel storage 15 Oil well/Gas well  
 3 Watertight sewer lines 6 Seepage pit 9 Feedyard 12 Fertilizer storage 16 Other (specify below)  
 13 Insecticide storage  
 Direction from well? How many feet?

FROM	TO	LITHOLOGIC LOG	FROM	TO	PLUGGING INTERVALS
0.0	27.0	BROWN & RED SILTY CLAY - MOIST / STIFF			
27.0	40.0	GRAY & RED SHALE - DRY / MED HARD			

7 CONTRACTOR'S OR LANDOWNER'S CERTIFICATION: This water well was (1) constructed, (2) reconstructed, or (3) plugged under my jurisdiction and was completed on (mo/day/year) 11-05-95 and this record is true to the best of my knowledge and belief. Kansas Water Well Contractor's License No. 351 This Water Well Record was completed on (mo/day/yr) 11-25-95 under the business name of Associated Environmental Industries by (signature) [Signature]

OFFICE USE ONLY