


1 LOCATION OF WATER WELL: **Sumner** FRACTION: **NE 1/4 NW 1/4 NE 1/4** Section Number: **13** Township Number: **T 32 S** Range Number: **R 2E E/W**

Distance and direction from nearest town or city street address of well if located within city?
1847 E. Highway 160 Oxford, Kansas

WATER WELL OWNER: **YOUNG, Paul** Board of Agriculture, Division of Water Resource
 RR#, ST. ADDRESS, BOX #: **1847 E. Highway 160**
 CITY, STATE, ZIP CODE: **Oxford, Kansas** Application Number:

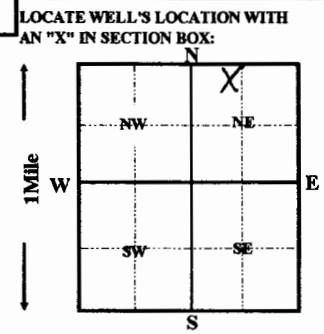

4 DEPTH OF COMPLETED WELL: **30** ft. ELEVATION:
 Depth(s) groundwater Encountered: **1** ft. **2** ft. **3** ft.
 WELL'S STATIC WATER LEVEL: **10** FT. BELOW LAND SURFACE MEASURED ON **10/28/1997**
 Pump test data: Well water was _____ ft. after _____ hours pumping _____ gpm
 Est. Yield _____ gpm: Well water was _____ ft. after _____ hours pumping _____ gpm
 Bore Hole Diameter: **12** in. to **30** ft. and _____ in. to _____ ft.
 WELL WATER TO BE USED AS:
 5 Public water supply 8 Air conditioning 11 Injection well
 1 Domestic 3 Feedlot 6 Oil field water supply 9 Dewatering 12 Other (Specify below)
 2 Irrigation 4 Industrial 7 Lawn and garden only 10 Monitoring well
 Was a chemical/bacteriological sample submitted to Department? Yes _____ No ; If yes, mo/day/yr sample was submitted
 Water Well Disinfected? Yes No

5 TYPE OF CASING USED:
 1 Steel 3 RMP (SR) 5 Wrought iron 8 Concrete tile CASING JOINTS: Glued Clamped
 2 PVC 4 ABS 6 Asbestos-Cement 9 Other (Specify below) Welded
 7 Fiberglass SDR-26 Threaded
 Blank casing Diameter: **5** in. to **20** ft., Dia _____ in. to _____ ft., Dia _____ in. to _____ ft.
 Casing height above land surface: **12** in., weight **2.35** lbs./ft. Wall thickness or gauge No. **.214**
 TYPE OF SCREEN OR PERFORATION MATERIAL:
 1 Steel 3 Stainless Steel 5 Fiberglass 8 RMP (SR) 11 other (specify)
 2 Brass 4 Galvanized steel 6 Concrete tile 9 ABS 12 None used (open hole)
 SCREEN OR PERFORATION OPENING ARE:
 1 Continuous slot 3 Mill slot 5 Gauzed wrapped 8 Saw cut 11 None (open hole)
 2 Louvered shutter 4 Key punched 6 Wire wrapped 9 Drilled holes
 7 Torch cut 10 Other (specify)
 SCREEN-PERFORATION INTERVALS: from **20** ft. to **30** ft., From _____ ft. to _____ ft.
 GRAVEL PACK INTERVALS: from **20** ft. to **30** ft., From _____ ft. to _____ ft.

6 GROUT MATERIAL: 1 Neat cement 2 Cement grout 3 Bentonite 4 Other **bentonite hole plug**
 Grout Intervals: From **0** ft. to **20** ft. From _____ ft. to _____ ft.
 What is the nearest source of possible contamination:
 1 Septic tank 4 Lateral lines 7 Pit privy 10 Livestock pens 14 Abandon water well
 2 Sewer lines 5 Cess pool 8 Sewage lagoon 11 Fuel storage 15 Oil well/Gas well
 3 Watertight sewer lines 6 Seepage pit 9 Feedyard 12 Fertilizer storage 16 Other (specify below)
 13 Insecticide storage **None Apparent**
 Direction from well? _____ How many feet? _____

FROM	TO	LITHOLOGIC LOG	FROM	TO	PLUGGING INTERVALS
0	20	fine sand			
20	30	medium fine sand			

7 CONTRACTOR'S OR LANDOWNER'S CERTIFICATION: This water well was (1) constructed, (2) reconstructed, or (3) plugged under my jurisdiction and was completed on (mo/day/year) **10/28/1997** and this record is true to the best of my knowledge and belief. Kansas Water Well Contractor's License No. **236** This Water Well Record was completed on (mo/day/yr) **10/30/97**
 Under the business name of **Harp Well & Pump Service, Inc.** by (signature) *Todd S. Harp*