

1 LOCATION OF WATER WELL: **Sumner** FRACTION **NE 1/4 NE 1/4 NE 1/4** Section Number **15** Township Number **T 32 S** Range Number **R 2E EW**


Distance and direction from nearest town or city street address of well if located within city?

1 1/4 m. W. of Oxford, S. side of Highway 60 Oxford, Kansas

WATER WELL OWNER: **SHORT, Don**
 RR#, ST. ADDRESS, BOX #: **P.O. Box 1**
 CITY, STATE, ZIP CODE: **Oxford, Kansas**

Board of Agriculture, Division of Water Resource
 Application Number:

LOCATE WELL'S LOCATION WITH AN "X" IN SECTION BOX:

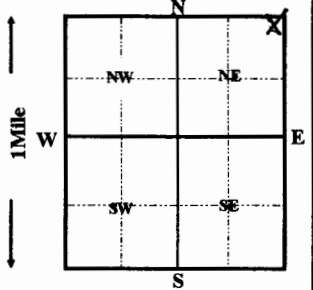

4 DEPTH OF COMPLETED WELL **50** ft. ELEVATION:
 Depth(s) groundwater Encountered **1** ft. **2** ft. **3** ft.
 WELL'S STATIC WATER LEVEL **25** FT. BELOW LAND SURFACE MEASURED ON **10/29/1997**
 Pump test data: Well water was _____ ft. after _____ hours pumping _____ gpm
 Est. Yield _____ gpm: Well water was _____ ft. after _____ hours pumping _____ gpm
 Bore Hole Diameter **12** in. to **50** ft. and _____ in. to _____ ft.
 WELL WATER TO BE USED AS: **5** Public water supply **8** Air conditioning **11** Injection well
1 Domestic **3** Feedlot **6** Oil field water supply **9** Dewatering **12** Other (Specify below)
2 Irrigation **4** Industrial **7** Lawn and garden only **10** Monitoring well
 Was a chemical/bacteriological sample submitted to Department? Yes _____ No ; If yes, mo/day/yr sample was submitted _____
 Water Well Disinfected? Yes No _____

5 TYPE OF CASING USED:
 1 Steel 3 RMP (SR) 5 Wrought iron 8 Concrete tile CASING JOINTS: Glued Clamped
 2 PVC 4 ABS 6 Asbestos-Cement 9 Other (Specify below) Welded
 7 Fiberglass SDR-26 Threaded
 Blank casing Diameter **5** in. to **30** ft., Dia _____ in. to _____ ft.
 Casing height above land surface **12** in., weight **2.35** lbs. / ft. Wall thickness or gauge No. **.214**
 TYPE OF SCREEN OR PERFORATION MATERIAL:
 1 Steel 3 Stainless Steel 5 Fiberglass 8 RMP (SR) 10 Asbestos-cement
 2 Brass 4 Galvanized steel 6 Concrete tile 9 ABS 11 other (specify)
 12 None used (open hole)
 SCREEN OR PERFORATION OPENING ARE:
 1 Continuous slot 3 Mill slot 5 Gauzed wrapped 8 Saw cut 11 None (open hole)
 2 Louvered shutter 4 Key punched 6 Wire wrapped 9 Drilled holes
 7 Torch cut 10 Other (specify)
 SCREEN-PERFORATION INTERVALS: from **30** ft. to **50** ft., From _____ ft. to _____ ft.
 GRAVEL PACK INTERVALS: from **24** ft. to **50** ft., From _____ ft. to _____ ft.

6 GROUT MATERIAL: 1 Neat cement 2 Cement grout 3 Bentonite 4 Other **bentonite hole plug**
 Grout Intervals: From **4** ft. to **24** ft. From _____ ft. to _____ ft.
 What is the nearest source of possible contamination:
 1 Septic tank 4 Lateral lines 7 Pit privy 10 Livestock pens 14 Abandon water well
 2 Sewer lines 5 Cess pool 8 Sewage lagoon 11 Fuel storage 15 Oil well/Gas well
 3 Watertight sewer lines 6 Seepage pit 9 Feedyard 12 Fertilizer storage 16 Other (specify below)
 13 Insecticide storage **None Apparent**

Direction from well? _____ How many feet? _____

FROM	TO	LITHOLOGIC LOG	FROM	TO	PLUGGING INTERVALS
0	4	topsoil			
4	23	clay			
23	30	fine sand			
30	45	medium sand			
45	50	shale			

7 CONTRACTOR'S OR LANDOWNER'S CERTIFICATION: This water well was (1) constructed, (2) reconstructed, or (3) plugged under my jurisdiction and was completed on (mo/day/year) 10/29/1997 and this record is true to the best of my knowledge and belief. Kansas Water Well Contractor's License No. 236 This Water Well Record was completed on (mo/day/yr) 10/30/97
 Under the business name of Harp Well & Pump Service, Inc by signature Todd S. Harp