


1 LOCATION OF WATER WELL:		Fraction	Section Number	Township Number		Range Number	
County: Sumner		SW ¼ SW ¼ SW ¼	12	T 32 S		R 2 E	

Distance and direction from nearest town or city street address of well if located within city?
Approx. 14' N, 10' E of NEC of Myrtle St. and Illinois Ave. - Oxford

2 | WATER WELL OWNER: **KDHE**
 RR#, St. Address, Box # : **1000 SW Jackson St., Ste. 410**
 City, State, ZIP Code : **Topeka, KS 66612**
 Board of Agriculture, Division of Water Resources
 Application Number:

3 | LOCATE WELL'S LOCATION WITH AN "X" IN SECTION BOX:

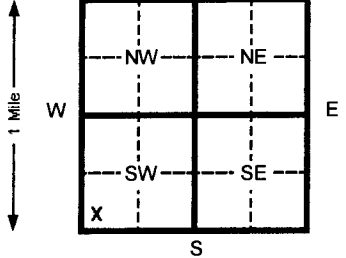

4 | DEPTH OF COMPLETED WELL **41.5** ft. ELEVATION: **1186.75 (TOC)**
 Depth(s) Groundwater Encountered 1 **39** ft. 2 _____ ft. 3 _____ ft.
 WELL'S STATIC WATER LEVEL **37.66** ft. below TOC measured on mo/day/yr **03/06/15**
 Pump test data: Well water was _____ ft. after _____ hours pumping _____ gpm
 Est. Yield _____ gpm: Well water was _____ ft. after _____ hours pumping _____ gpm
 Bore Hole Diameter **8.25** in. to **41.5** ft. and _____ in. to _____ ft.
 WELL WATER TO BE USED AS: 5 Public water supply 8 Air conditioning 11 Injection well
 1 Domestic 3 Feed lot 6 Oil field water supply 9 Dewatering 12 Other (Specify below)
 2 Irrigation 4 Industrial 7 Lawn and garden (domestic) **10 Monitoring well**
 Was a chemical/bacteriological sample submitted to Department? Yes _____ No **X** If yes, mo/day/yr sample was submitted
 Water Well Disinfected? Yes _____ No **X**

5 | TYPE OF BLANK CASING USED: 5 Wrought Iron 8 Concrete tile CASING JOINTS: Glued _____ Clamped _____
 1 Steel 3 RMP (SR) 6 Asbestos-Cement 9 Other (specify below) Welded _____
2 PVC 4 ABS 7 Fiberglass **Threaded Flush**

Blank casing diameter **2** in. to **26.5** ft. Dia _____ in. to _____ ft. Dia _____ in. to _____ ft.
 Casing height above land surface **0** in., weight **0.703** lbs./ft. Wall thickness or gauge No. **SCH. 40**

TYPE OF SCREEN OR PERFORATION MATERIAL: **7 PVC** 10 Asbestos-cement
 1 Steel 3 Stainless steel 5 Fiberglass 8 RMP (SR) 11 Other (specify) _____
 2 Brass 4 Galvanized steel 6 Concrete tile 9 ABS 12 None used (open hole)

SCREEN OR PERFORATION OPENINGS ARE: 5 Gauzed wrapped 8 Saw cut 11 None (open hole)
 1 Continuous slot **3 Mill slot** 6 Wire wrapped 9 Drilled holes
 2 Louvered shutter 4 Key punched 7 Torch cut 10 Other (specify) _____

SCREEN-PERFORATED INTERVALS: From **26.5** ft. to **41.5** ft. From _____ ft. to _____ ft.
 From _____ ft. to _____ ft. From _____ ft. to _____ ft.

GRAVEL PACK INTERVALS: From **24.5** ft. to **41.5** ft. From _____ ft. to _____ ft.
 From _____ ft. to _____ ft. From _____ ft. to _____ ft.

6 | GROUT MATERIAL: 1 Neat cement 2 Cement grout **3 Bentonite** 4 Other _____
 Grout Intervals From **3** ft. to **24.5** ft. From _____ ft. to _____ ft. From _____ ft. to _____ ft.

What is the nearest source of possible contamination:
 1 Septic tank 4 Lateral lines 7 Pit privy 10 Livestock pens 14 Abandoned water well
 2 Sewer lines 5 Cess pool 8 Sewage lagoon 11 Fuel storage 15 Oil well/ Gas well
 3 Watertight sewer lines 6 Seepage pit 9 Feedyard 12 Fertilizer storage 16 Other (specify below)
 13 Insecticide storage _____

Direction from well? _____ How many feet? _____

FROM	TO	CODE	LITHOLOGIC LOG	FROM	TO	PLUGGING INTERVALS
0	2		Topsoil, sandy clay, dark brown			
2	8		Sandy Clay, brown			
8	17		Silty Clay, red brown, some fine sand			
17	32		Sandy Clay, fine sand			
32	41.5		Sand			

Survey date: **04/02/15**; Datum: **NAD83**
 Latitude: **N 37.27549**
 Longitude: **W 97.16761**

7 | CONTRACTOR'S OR LANDOWNER'S CERTIFICATION: This water well was **(1) constructed**, (2) reconstructed, or (3) plugged under my jurisdiction and was completed on (mo/day/yr) **03/05/15** and this record is true to the best of my knowledge and belief. Kansas Water Well Contractor's License No. **531** This Water Well Record was completed on (mo/day/yr) **04/17/15** under the business name of **GSI Engineering, LLC** by (signature) *Imai Chade*

INSTRUCTIONS: Please fill in blanks and circle the correct answers. Send three copies to Kansas Department of Health and Environment, Bureau of Water, 1000 S W Jackson St., Ste. 420, Topeka, Kansas 66612-1367. Telephone: 913-296-5545. Send one to WATER WELL OWNER and retain one for your records.