


1 LOCATION OF WATER WELL: County: Sumner Fraction: Sw 1/4 Sw 1/4 Sw 1/4 Section Number: 12 Township Number: T 32 S Range Number: R 2 EW

Distance and direction from nearest town or city street address of well if located within city?
202 North Sumner

2 WATER WELL OWNER: James Schiff Board of Agriculture, Division of Water Resources
 RR#, St. Address, Box #: RR3, Box 66A Application Number:
 City, State, ZIP Code: Udall, Kansas

3 LOCATE WELL'S LOCATION WITH AN "X" IN SECTION BOX:

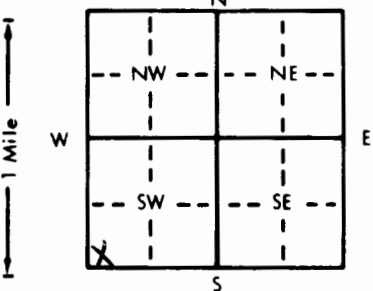

4 DEPTH OF COMPLETED WELL: 44.5 ft. ELEVATION: 1180.3

Depth(s) Groundwater Encountered 1. 38.5 ft. 2. _____ ft. 3. _____ ft.
 WELL'S STATIC WATER LEVEL 39.70 ft. below land surface measured on mo/day/yr 5/3/91
 Pump test data: Well water was _____ ft. after _____ hours pumping _____ gpm
 Est. Yield _____ gpm: Well water was _____ ft. after _____ hours pumping _____ gpm
 Bore Hole Diameter: 8.25 in. to _____ in. and _____ in. to _____ in. ft.
 WELL WATER TO BE USED AS: 5 Public water supply 8 Air conditioning 11 Injection well
 1 Domestic 3 Feedlot 6 Oil field water supply 9 Dewatering 12 Other (Specify below)
 2 Irrigation 4 Industrial 7 Lawn and garden only 10 Monitoring well MW#1
 Was a chemical/bacteriological sample submitted to Department? Yes _____ No If yes, mo/day/yr sample was sub-
 mitted Water Well Disinfected? Yes _____ No

5 TYPE OF BLANK CASING USED: 1 Steel 3 RMP (SR) 5 Wrought iron 8 Concrete tile CASING JOINTS: Glued _____ Clamped _____
2 PVC 4 ABS 6 Asbestos-Cement 9 Other (specify below) Welded _____
 7 Fiberglass Threaded

Blank casing diameter: 2 in. to 34.0 ft., Dia _____ in. to _____ ft., Dia _____ in. to _____ ft.
 Casing height above land surface: 0 in., weight _____ lbs./ft. Wall thickness or gauge No. _____

TYPE OF SCREEN OR PERFORATION MATERIAL: 3 PVC 10 Asbestos-cement
 1 Steel 3 Stainless steel 5 Fiberglass 8 RMP (SR) 11 Other (specify) _____
 2 Brass 4 Galvanized steel 6 Concrete tile 9 ABS 12 None used (open hole)

SCREEN OR PERFORATION OPENINGS ARE: 1 Continuous slot 3 Mill slot 5 Gauzed wrapped 8 Saw cut 11 None (open hole)
 2 Louvered shutter 4 Key punched 6 Wire wrapped 9 Drilled holes
 7 Torch cut 10 Other (specify) _____

SCREEN-PERFORATED INTERVALS: From 34.0 ft. to 44.5 ft., From _____ ft. to _____ ft.
 From _____ ft. to _____ ft., From _____ ft. to _____ ft.
 GRAVEL PACK INTERVALS: From 32.0 ft. to 44.5 ft., From _____ ft. to _____ ft.
 From _____ ft. to _____ ft., From _____ ft. to _____ ft.

6 GROUT MATERIAL: 1 Neat cement 2 Cement grout 3 Bentonite 4 Other _____
 Grout Intervals: From 0.5 ft. to 32 ft., From _____ ft. to _____ ft., From _____ ft. to _____ ft.

What is the nearest source of possible contamination: 1 Septic tank 4 Lateral lines 7 Pit privy 11 Fuel storage 14 Abandoned water well
 2 Sewer lines 5 Cess pool 8 Sewage lagoon 12 Fertilizer storage 15 Oil well/Gas well
 3 Watertight sewer lines 6 Seepage pit 9 Feedyard 13 Insecticide storage 16 Other (specify below)
 Direction from well? North How many feet? 10

FROM	TO	LITHOLOGIC LOG	FROM	TO	PLUGGING INTERVALS
0	6"	Concrete Pavement			
6"	1.0'	Fill, Sand, Br.			
1.0'	3.0'	CL, VDK BR.			
3.0'	5.5'	alluv, CL, DK BR.			
5.5'	12.0'	CL, DK R BR.			
12.0'	28.5'	CL, R BR.			
28.5'	44.0'	Sand, BR, fine to medium gr. Poorly graded			
44.0'	44.5'	Wellington Shale, greenish gray, Sand.			

7 CONTRACTOR'S OR LANDOWNER'S CERTIFICATION: This water well was 1 constructed, (2) reconstructed, or (3) plugged under my jurisdiction and was completed on (mo/day/year) 4/26/91 and this record is true to the best of my knowledge and belief. Kansas Water Well Contractor's License No. 531 This Water Well Record was completed on (mo/day/yr) 7/2/91 under the business name of Geotechnical Services Inc. by (signature) Donda Hude Wallace