


OW 8

1 LOCATION OF WATER WELL: County: Sumner Fraction: NW 1/4 SW 1/4 SW 1/4 Section Number: 12 Township Number: T 32 S Range Number: R 2 E/W

Distance and direction from nearest town or city street address of well if located within city? 120 N Sumner, Oxford KS

2 WATER WELL OWNER: James L Schiff RR#, St. Address, Box #: R.R.#3 Box 66A City, State, ZIP Code: Udall KS 67146 Board of Agriculture, Division of Water Resources Application Number:

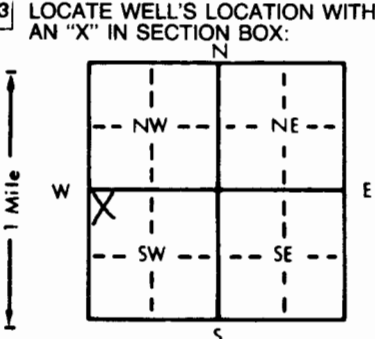

3 LOCATE WELL'S LOCATION WITH AN 'X' IN SECTION BOX: 4 DEPTH OF COMPLETED WELL: 45.0' ft. ELEVATION: NA Depth(s) Groundwater Encountered 1. 43' ft. 2. ft. 3. ft. WELL'S STATIC WATER LEVEL: 38.56' ft. below land surface measured on mo/day/yr 5-15-92 Pump test data: Well water was ft. after hours pumping gpm Est. Yield gpm: Well water was ft. after hours pumping gpm Bore Hole Diameter: 8 in. to ft., and in. to ft. WELL WATER TO BE USED AS: 5 Public water supply 8 Air conditioning 11 Injection well 1 Domestic 3 Feedlot 6 Oil field water supply 9 Dewatering 12 Other (Specify below) 2 Irrigation 4 Industrial 7 Lawn and garden only 10 Monitoring well Observation well Was a chemical/bacteriological sample submitted to Department? Yes No X; If yes, mo/day/yr sample was submitted Water Well Disinfected? Yes No X

5 TYPE OF BLANK CASING USED: 1 Steel 3 RMP (SR) 5 Wrought iron 8 Concrete tile CASING JOINTS: Glued Clamped 2 PVC 4 ABS 6 Asbestos-Cement 9 Other (specify below) Welded 7 Fiberglass Threaded Flush Blank casing diameter 2 in. to ft., Dia. in. to ft., Dia. in. to ft. Casing height above land surface: Flush in., weight 70.3 lbs./ft. Wall thickness or gauge No. 15.4 TYPE OF SCREEN OR PERFORATION MATERIAL: 1 Steel 3 Stainless steel 5 Fiberglass 7 PVC 8 RMP (SR) 10 Asbestos-cement 2 Brass 4 Galvanized steel 6 Concrete tile 9 ABS 11 Other (specify) 12 None used (open hole) SCREEN OR PERFORATION OPENINGS ARE: 1 Continuous slot 3 Mill slot 5 Gauzed wrapped 8 Saw cut 11 None (open hole) 2 Louvered shutter 4 Key punched 6 Wire wrapped 9 Drilled holes 7 Torch cut 10 Other (specify) SCREEN-PERFORATED INTERVALS: From 34.6 ft. to 44.6 ft., From ft. to ft. GRAVEL PACK INTERVALS: From 32.0 ft. to 44.6 ft., From ft. to ft.

6 GROUT MATERIAL: 1 Neat cement 2 Cement grout 3 Bentonite 4 Other Grout Intervals: From 32.0 ft. to 1.0 ft., From ft. to ft., From ft. to ft. What is the nearest source of possible contamination: 1 Septic tank 4 Lateral lines 7 Pit privy 10 Livestock pens 14 Abandoned water well 2 Sewer lines 5 Cess pool 8 Sewage lagoon 11 Fuel storage 15 Oil well/Gas well 3 Watertight sewer lines 6 Seepage pit 9 Feedyard 12 Fertilizer storage 16 Other (specify below) 13 Insecticide storage Direction from well? Southeast How many feet? 100'

FROM	TO	LITHOLOGIC LOG	FROM	TO	PLUGGING INTERVALS
0.0	4.0	Fill material			
4.0	17.5	Clay, silty, soft dark brown			
17.5	28.0	Clay, carbon staining dark brown			
28.0	35.0	Sand, fine to medium grained, reddish brown			
35.0	43.0	Sand, fine to medium grained, brown			
43.0	45.0	Shale, grey green			

Flush mount waiver granted on 4-21-92 for Abandoned Conoco, Oxford KS by Don Taylor

7 CONTRACTOR'S OR LANDOWNER'S CERTIFICATION: This water well was (1) constructed, (2) reconstructed, or (3) plugged under my jurisdiction and was completed on (mo/day/year) 4-24-92 and this record is true to the best of my knowledge and belief. Kansas Water Well Contractor's License No. 531 This Water Well Record was completed on (mo/day/yr) 6-3-92 under the business name of Geotechnical Services, Inc by (signature) Allison Irwin