


MW-7

1 LOCATION OF WATER WELL: County: <u>Sumner</u>	Fraction <u>NW 1/4 SW 1/4 SW 1/4</u>	Section Number <u>12</u>	Township Number T <u>32</u> S	Range Number R <u>2</u> EW
--	---	-----------------------------	----------------------------------	-------------------------------

Distance and direction from nearest town or city street address of well if located within city?
120 N Sumner, Oxford KS

2 WATER WELL OWNER: RR#, St. Address, Box # : City, State, ZIP Code	<u>James L. Schiff</u> <u>R.D. #3 Box 66A</u> <u>Udall KS 67146</u>	Board of Agriculture, Division of Water Resources Application Number:
---	---	--

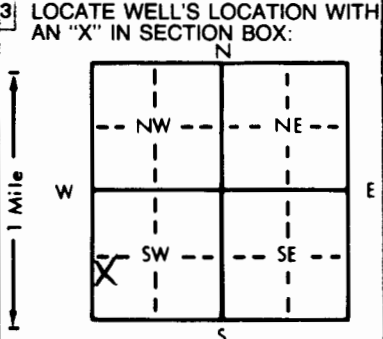

4 DEPTH OF COMPLETED WELL: <u>45.0'</u> ft. ELEVATION: <u>NA</u>
Depth(s) Groundwater Encountered 1. <u>43</u> ft. 2. _____ ft. 3. _____ ft.
WELL'S STATIC WATER LEVEL <u>39.54</u> ft. below land surface measured on mo/day/yr <u>5-15-92</u>
Pump test data: Well water was _____ ft. after _____ hours pumping _____ gpm
Est. Yield _____ gpm: Well water was _____ ft. after _____ hours pumping _____ gpm
Bore Hole Diameter: <u>8</u> in. to _____ ft., and _____ in. to _____ ft.
WELL WATER TO BE USED AS:
5 Public water supply 8 Air conditioning 11 Injection well
1 Domestic 3 Feedlot 6 Oil field water supply 9 Dewatering 12 Other (Specify below)
2 Irrigation 4 Industrial 7 Lawn and garden only <u>10 Monitoring well</u>
Was a chemical/bacteriological sample submitted to Department? Yes _____ No <u>X</u> ; If yes, mo/day/yr sample was submitted _____
Water Well Disinfected? Yes _____ No <u>X</u>

5 TYPE OF BLANK CASING USED:	5 Wrought iron	8 Concrete tile	CASING JOINTS: Glued _____ Clamped _____
1 Steel	3 RMP (SR)	6 Asbestos-Cement	9 Other (specify below)
<u>2 PVC</u>	4 ABS	7 Fiberglass	Welded _____
Blank casing diameter <u>2</u> in. to _____ ft., Dia _____ in. to _____ ft., Dia _____ in. to _____ ft.			Threaded <u>Flush</u>
Casing height above land surface <u>Flush</u> in., weight <u>70.3</u> lbs./ft. Wall thickness or gauge No. <u>154</u>			
TYPE OF SCREEN OR PERFORATION MATERIAL:			
1 Steel	3 Stainless steel	5 Fiberglass	8 RMP (SR)
2 Brass	4 Galvanized steel	6 Concrete tile	9 ABS
SCREEN OR PERFORATION OPENINGS ARE:			
1 Continuous slot	<u>3 Mill slot</u>	5 Gauzed wrapped	8 Saw cut
2 Louvered shutter	4 Key punched	6 Wire wrapped	9 Drilled holes
SCREEN-PERFORATED INTERVALS: From <u>34.5</u> ft. to <u>44.5</u> ft., From _____ ft. to _____ ft.			
GRAVEL PACK INTERVALS: From <u>32.5</u> ft. to <u>44.5</u> ft., From _____ ft. to _____ ft.			

6 GROUT MATERIAL:	1 Neat cement	2 Cement grout	<u>3 Bentonite</u>	4 Other _____
Grout Intervals: From <u>32.5</u> ft. to <u>1.0</u> ft., From _____ ft. to _____ ft., From _____ ft. to _____ ft.				
What is the nearest source of possible contamination:				
1 Septic tank	4 Lateral lines	7 Pit privy	<u>11 Fuel storage</u>	14 Abandoned water well
2 Sewer lines	5 Cess pool	8 Sewage lagoon	12 Fertilizer storage	15 Oil well/Gas well
3 Watertight sewer lines	6 Seepage pit	9 Feedyard	13 Insecticide storage	16 Other (specify below)
Direction from well? <u>East</u>			How many feet? <u>~140</u>	

FROM	TO	LITHOLOGIC LOG	FROM	TO	PLUGGING INTERVALS
0.0	3.5	Fill material			
3.5	13.5	Clay, brown			
3.5	13.5	Clay, brown			
13.5	18.5	Clay, brown, very little silt			
18.5	23.5	Clay, very little silt, iron deposit, light brown			
23.5	33.5	Clay, silty iron deposit			
33.5	37.0	Sand, medium grained			
37.0	42.0	Sand, fine to medium grained			
42.0	45.0	Shale, grey green			
Flush mount waiver granted on 4-21-92 for Abandoned Conoco, Oxford KS by Don Taylor					

7 CONTRACTOR'S OR LANDOWNER'S CERTIFICATION: This water well was <u>(1) constructed</u> , (2) reconstructed, or (3) plugged under my jurisdiction and was completed on (mo/day/year) <u>4-24-92</u> and this record is true to the best of my knowledge and belief. Kansas Water Well Contractor's License No. <u>531</u> This Water Well Record was completed on (mo/day/yr) <u>6-3-92</u> under the business name of <u>Geotechnical Services, Inc</u> by (signature) <u>Allison Irwin</u>
--