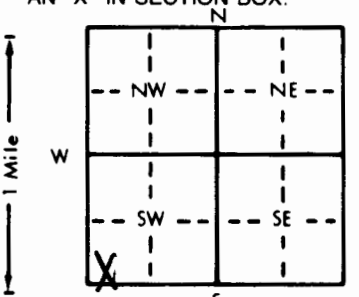


1 LOCATION OF WATER WELL: County: Sumner Fraction: Sw 1/4 Sw 1/4 Sw 1/4 Section Number: 12 Township Number: T 32 S Range Number: R 2 E

Distance and direction from nearest town or city street address of well if located within city?
202 North Sumner, Oxford, Ks.

2 WATER WELL OWNER: James Schiff
 RR#, St. Address, Box #: RR 3, Box 66A Board of Agriculture, Division of Water Resources
 City, State, ZIP Code: Udall, Kansas Application Number:

3 LOCATE WELL'S LOCATION WITH AN "X" IN SECTION BOX:  4 DEPTH OF COMPLETED WELL: 43.5 ft. ELEVATION: 1177.89
 Depth(s) Groundwater Encountered 1. 39.5 ft. 2. _____ ft. 3. _____ ft.
 WELL'S STATIC WATER LEVEL: 38.94 ft. below land surface measured on mo/day/yr 5/13/91
 Pump test data: Well water was _____ ft. after _____ hours pumping _____ gpm
 Est. Yield _____ gpm: Well water was _____ ft. after _____ hours pumping _____ gpm
 Bore Hole Diameter: 8.25 in. to _____ ft., and _____ in. to _____ ft.
 WELL WATER TO BE USED AS: 5 Public water supply 8 Air conditioning 11 Injection well
 1 Domestic 3 Feedlot 6 Oil field water supply 9 Dewatering 12 Other (Specify below)
 2 Irrigation 4 Industrial 7 Lawn and garden only 10 Monitoring well MW#3
 Was a chemical/bacteriological sample submitted to Department? Yes _____ No _____; If yes, mo/day/yr sample was submitted _____
 Water Well Disinfected? Yes _____ No

5 TYPE OF BLANK CASING USED: 1 Steel 3 RMP (SR) 5 Wrought iron 8 Concrete tile CASING JOINTS: Glued _____ Clamped _____
2 PVC 4 ABS 6 Asbestos-Cement 9 Other (specify below) Welded _____
 7 Fiberglass Threaded _____
 Blank casing diameter: 2 in. to 31 ft., Dia _____ in. to _____ ft., Dia _____ in. to _____ ft.
 Casing height above land surface: 0 in., weight _____ lbs./ft. Wall thickness or gauge No. _____
 TYPE OF SCREEN OR PERFORATION MATERIAL: 7 PVC 10 Asbestos-cement
 1 Steel 3 Stainless steel 5 Fiberglass 8 RMP (SR) 11 Other (specify) _____
 2 Brass 4 Galvanized steel 6 Concrete tile 9 ABS 12 None used (open hole)
 SCREEN OR PERFORATION OPENINGS ARE: 5 Gauzed wrapped 8 Saw cut 11 None (open hole)
 1 Continuous slot 3 Mill slot 6 Wire wrapped 9 Drilled holes
 2 Louvered shutter 4 Key punched 33 7 Torch cut 43.5 10 Other (specify) _____
 SCREEN-PERFORATED INTERVALS: From 33 ft. to 43.5 ft., From _____ ft. to _____ ft.
 From _____ ft. to _____ ft., From _____ ft. to _____ ft.
 GRAVEL PACK INTERVALS: From 31 ft. to 43.5 ft., From _____ ft. to _____ ft.
 From _____ ft. to _____ ft., From _____ ft. to _____ ft.

6 GROUT MATERIAL: 1 Neat cement 2 Cement grout 3 Bentonite 4 Other _____
 Grout Intervals: From 0.5 ft. to 31 ft., From _____ ft. to _____ ft., From _____ ft. to _____ ft.
 What is the nearest source of possible contamination:
 1 Septic tank 4 Lateral lines 7 Pit privy 10 Livestock pens 14 Abandoned water well
2 Sewer lines 5 Cess pool 8 Sewage lagoon 11 Fuel storage 15 Oil well/Gas well
 3 Watertight sewer lines 6 Seepage pit 9 Feedyard 12 Fertilizer storage 16 Other (specify below)
 13 Insecticide storage
 Direction from well? NS How many feet? 10'

FROM	TO	LITHOLOGIC LOG	FROM	TO	PLUGGING INTERVALS
0	6"	<u>Asphalt Pavement</u>			
6"	3.5	<u>Fill: CL, BLK, Moist</u>			
3.5	7.0	<u>alluv; CL, DK OLIVE GR</u>			
7.0	14.0	<u>CL, DK Bl.</u>			
14.0	17.0	<u>CL, DK GR Br.</u>			
17.0	22.5	<u>CL, DK OLIVE GR</u>			
22.5	34.0	<u>Sand, BROWN</u>			
34.0	39.0	<u>Sand, Y Red</u>			
39.0	43.5	<u>Sand, Bl.</u>			

fine grained, poorly graded
fine medium grain, poorly graded
fine - coarse grain, well graded

7 CONTRACTOR'S OR LANDOWNER'S CERTIFICATION: This water well was (1) constructed, (2) reconstructed, or (3) plugged under my jurisdiction and was completed on (mo/day/year) 4/26/91 and this record is true to the best of my knowledge and belief. Kansas Water Well Contractor's License No. 531 This Water Well Record was completed on (mo/day/yr) 7/2/91 under the business name of Geotechnical Services Inc. by (signature) Andie Hude-Lenlace