


1 LOCATION OF WATER WELL: Fraction SW 1/4 SW 1/4 SW 1/4 Section Number 24 Township Number T 32 S Range Number R 2 E E/W  
 County: SUMNER 191

Distance and direction from nearest town or city street address of well if located within city?  
1 1/2 miles SOUTH of Oxford, Ks. SW corner

2 WATER WELL OWNER: David Lee  
 RR#, St. Address, Box #: R #1 Box 58 Board of Agriculture, Division of Water Resources  
 City, State, ZIP Code: Oxford, Kansas Application Number                     

3 LOCATE WELL'S LOCATION WITH AN "X" IN SECTION BOX: X in SW corner of section  
 4 DEPTH OF COMPLETED WELL: 55 ft. ELEVATION:                     

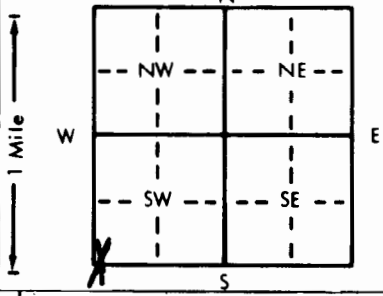

Depth(s) Groundwater Encountered 1. 21 ft. 2.                      ft. 3.                      ft.  
 WELL'S STATIC WATER LEVEL .21 ft. below land surface measured on mo/day/yr 7-23-84 ✓  
 Pump test data: Well water was                      ft. after                      hours pumping                      gpm  
 Est. Yield                      gpm: Well water was                      ft. after                      hours pumping                      gpm  
 Bore Hole Diameter .11 in. (to 55 ft.), and                      in. to                      ft.  
 WELL WATER TO BE USED AS:  
 5 Public water supply 8 Air conditioning 11 Injection well  
 1 Domestic 3 Feedlot 6 Oil field water supply 9 Dewatering 12 Other (Specify below)  
 2 Irrigation 4 Industrial 7 Lawn and garden only 10 Observation well  
 Was a chemical/bacteriological sample submitted to Department? Yes                      No X; If yes, mo/day/yr sample was submitted                       
 Water Well Disinfected? Yes X No                     

5 TYPE OF BLANK CASING USED:  
 1 Steel 3 RMP (SR) 5 Wrought iron 8 Concrete tile CASING JOINTS: Glued X Clamped                       
 2 PVC 4 ABS 6 Asbestos-Cement 9 Other (specify below) Welded                       
 7 Fiberglass Cer-Mac Styrene SDR-26 ✓ Threaded                     

Blank casing diameter 5 in. to 40 ft., Dia                      in. to                      ft., Dia                      in. to                      ft.  
 Casing height above land surface 12 in., weight 1.59 lbs./ft. Wall thickness or gauge No. 203

TYPE OF SCREEN OR PERFORATION MATERIAL:  
 1 Steel 3 Stainless steel 5 Fiberglass 8 RMP (SR) 10 Asbestos-cement 11 Other (specify)                       
 2 Brass 4 Galvanized steel 6 Concrete tile 9 ABS 12 None used (open hole)

SCREEN OR PERFORATION OPENINGS ARE:  
 1 Continuous slot 3 Mill slot 5 Gauzed wrapped 8 Saw cut 11 None (open hole)  
 2 Louvered shutter 4 Key punched 6 Wire wrapped 9 Drilled holes  
 7 Torch cut 10 Other (specify)                     

SCREEN-PERFORATED INTERVALS: From 40 ft. to 55 ft., From                      ft. to                      ft.  
 From                      ft. to                      ft., From                      ft. to                      ft.  
 GRAVEL PACK INTERVALS: From 14 ft. to 55 ft., From                      ft. to                      ft.  
 From                      ft. to                      ft., From                      ft. to                      ft.

6 GROUT MATERIAL: 1 Neat cement 2 Cement grout 3 Bentonite 4 Other                       
 Grout Intervals: From 4 ft. to 14 ft., From                      ft. to                      ft., From                      ft. to                      ft.

What is the nearest source of possible contamination:  
 1 Septic tank 4 Lateral lines 7 Pit privy 10 Livestock pens 14 Abandoned water well  
 2 Sewer lines 5 Cess pool 8 Sewage lagoon 11 Fuel storage 15 Oil well/Gas well  
 3 Watertight sewer lines 6 Seepage pit 9 Feedyard 12 Fertilizer storage 16 Other (specify below)                       
 13 Insecticide storage                     

Direction from well? West How many feet? 78

FROM	TO	LITHOLOGIC LOG	FROM	TO	LITHOLOGIC LOG
0	3	Topsoil			
3	29 <u>01</u>	Clay			
29	51 <u>07</u>	Fine Sand			
51	55 <u>08</u>	Medium Sand			

7 CONTRACTOR'S OR LANDOWNER'S CERTIFICATION: This water well was (1) constructed, (2) reconstructed, or (3) plugged under my jurisdiction and was completed on (mo/day/year) 7-23-84 and this record is true to the best of my knowledge and belief. Kansas Water Well Contractor's License No. 236 This Water Well Record was completed on (mo/day/yr) 11-1-84 under the business name of Harp Well & Pump Service, Inc. by (signature) Mary Arnold

INSTRUCTIONS: Use typewriter or ball point pen, PLEASE PRESS FIRMLY and PRINT clearly. Please fill in blanks, underline or circle the correct answers. Send top three copies to Kansas Department of Health and Environment, Division of Environment, Environmental Geology Section, Topeka, KS 66620. Send one to WATER WELL OWNER and retain one for your records.

OFFICE USE ONLY T 32 R 2 E/W SEC. 24 SW 1/4 SW 1/4 SW 1/4