

County: Labette Fraction NW SW SE NE Sec. 6 T 32 S R 21 EW

CORRECTION(S) TO WATER WELL COMPLETION RECORD (WWC-5)  
(to rectify lacking or incorrect information)

Owner: USACE

Location was listed as:

Section-Township-Range: 2-32 S-19 E

Fraction (1/4 1/4 1/4): NW SW SE NE

Location changed to:

6-32 S-21 E

NW SW SE NE

Other changes: Initial statements: \_\_\_\_\_

Changed to: \_\_\_\_\_

Comments: \_\_\_\_\_

Verification method: Latitude & longitude & KGS' "LEO" lat/long-  
conversion tool, and mapping tool on KGS website.

initials: ORA date: 4/17/2017

Submitted by: Kansas Geological Survey, Data Resources Library, 1930 Constant Ave., Lawrence, KS 66047-3726  
to: Kansas Dept of Health & Environment, Bureau of Water, 1000 SW Jackson, Suite 420, Topeka, KS 66612-1367.

**WATER WELL PLUGGING RECORD Form WWC-5P**

KSA 82a-1212

ID NO.

MW-21-6


**1 LOCATION OF WATER WELL:** Fraction NW 1/4 SW 1/4 SE 1/4 NE 1/4 Section Number 02 Township Number T 32 S Range Number 19  E  W  
 County: \_\_\_\_\_

Street/Rural Address of Well Location; if unknown, distance & direction from nearest town or intersection: If at owner's address, check here  1315' E-SE From the intersection of Utica Rd and 20800 Rd

**Global Positioning Systems (GPS) information:**  
 Latitude: 37.289823611 (in decimal degrees)  
 Longitude: -95.144693611 (in decimal degrees)  
 Elevation: 845.74 ft.  
 Horizontal Datum:  WGS84,  NAD83,  NAD27  
 Collection Method: \_\_\_\_\_

**2 WATER WELL OWNER:** USACE  
 RR#, St. Address, Box #: 601 E 12th St  
 City, State ZIP Code: KCMO 64106

GPS unit (Make/Model: Trimble Geoexplorer 6000)  
 Digital Map/Photo,  Topographic Map,  Land Survey  
 Est. Accuracy:  < 3 m,  3-5 m,  5-15 m,  > 15 m

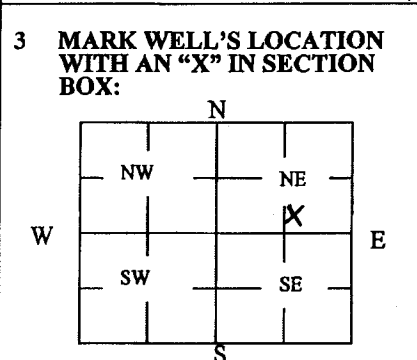

**4 DEPTH OF WELL** 18.9 ft.  
 WELL'S STATIC WATER LEVEL 3.45 ft.  
 WELL WAS USED AS:  
 Domestic  Public Water Supply  Dewatering  
 Irrigation  Oil Field Water Supply  Monitoring  
 Feedlot  Domestic (Lawn & Garden)  Injection Well  
 Industrial  Air Conditioning  Other \_\_\_\_\_  
 Was a chemical/bacteriological sample submitted to Department? Yes  No

**5 TYPE OF BLANK CASING USED:**  
 Steel  RMP (SR)  Wrought  Fiberglass  Other (Specify below)  
 PVC  ABS  Asbestos-Cement  Concrete Tile  
 Blank casing diameter 2.0 in. Was casing pulled? Yes  No  If yes, how much 20.6'  
 Casing height above or below land surface 20 above in.

**6 GROUT PLUG MATERIAL:**  Neat cement  Cement grout  Bentonite  Other 3% bentonite by wt.  
 Grout Plug Intervals: From 18.9 ft. to 3.0 ft., From \_\_\_\_\_ ft. to \_\_\_\_\_ ft., From \_\_\_\_\_ ft. to \_\_\_\_\_ ft.  
 What is the nearest source of possible contamination: \* ~3% Bentonite / cement grout mixture  
 Septic tank  Seepage pit  Fuel storage  Other (specify below)  
 Sewer lines  Pit privy  Fertilizer storage  
 Watertight sewer lines  Sewage lagoon  Insecticide storage  
 Lateral lines  Feedyard  Abandoned water well Direction from well? \_\_\_\_\_  
 Cess pool  Livestock pens  Oil well/Gas well How many feet? \_\_\_\_\_

FROM	TO	PLUGGING MATERIALS	FROM	TO	PLUGGING MATERIALS
0.0	3.0 ft	native soil			
3.0 ft	18.9 ft	3% Bentonite grout			

**7 CONTRACTOR'S OR LANDOWNER'S CERTIFICATION:** This water well was plugged under my jurisdiction and was completed on (mo/day/year) 10/12/2016 and this record is true to the best of my knowledge and belief. Kansas Water Well Contractor's License No. NA. This Water Well Record was completed on (mo/day/year) 10/17/2016 under the business name of USACE by (signature) NA per US Gov