

County: Labette Fraction: NE NW SE NE Sec. 6 T 32 S R 21 E

CORRECTION(S) TO WATER WELL COMPLETION RECORD Form WWC-5 (to rectify lacking or incorrect information)

Owner: Kansas Army Ammunition Plant Parsons Kansas

If location corrected, was listed as:

Location changed to:

Section-Township-Range: 6-325-21E

6-325-21E

Fraction (1/4 calls): NE SE

NE NW SE NE

Other changes: Initial statements: Latitude: 44.8727484, Longitude: -74.5133176,
NAD 83

Changed to: Latitude: 37.291726, Longitude: -95.142681,
NAD 83

Comments: _____

Verification method: Communication from well contractor, latitude & longitude
& KGS' "LEO" conversion tool, and mapping tool & aerial photos
on KGS website.

Initials: DRB Date: 6/6/2018

Submitted by: Kansas Geological Survey, Data Resources Library, 1930 Constant Avenue, Lawrence, KS 66047-3724
 Kansas Dept. of Health & Environment, Bureau of Water, 1000 SW Jackson, Suite 420, Topeka, KS 66612-1367

WATER WELL PLUGGING RECORD Form WWC-5P KSA 82a-1212 ID NO.

22-6


| | | | | |
|--|--|----------------------------|----------------------------------|--|
| 1 LOCATION OF WATER WELL: County: <u>LABETTE</u> | Fraction <u>NE 1/4 SE 1/4 1/4 1/4</u> | Section Number <u>6</u> | Township Number <u>T 32 S</u> | Range Number <u>21</u> <input checked="" type="checkbox"/> E <input type="checkbox"/> W |
|--|--|----------------------------|----------------------------------|--|

Street/Rural Address of Well Location; if unknown, distance & direction from nearest town or intersection: If at owner's address, check here **KANSAS ARMY AMMUNITION PLANT PARSONS KANSAS ~1,635 ft southwest of Road G and Road D intersection**

Global Positioning Systems (GPS) information:
 Latitude: 44.8727484 (in decimal degrees)
 Longitude: -74.5133176 (in decimal degrees)
 Elevation: 840.19
 Horizontal Datum: WGS84, NAD83, NAD27
 Collection Method:

2 WATER WELL OWNER: KANSAS ARMY
 RR#, St. Address, Box #: AMMUNITION PLANT
 City, State ZIP Code: PARSONS KANSAS

GPS unit (Make/Model: _____)
 Digital Map/Photo, Topographic Map, Land Survey
 Est. Accuracy: < 3 m, 3-5 m, 5-15 m, > 15 m

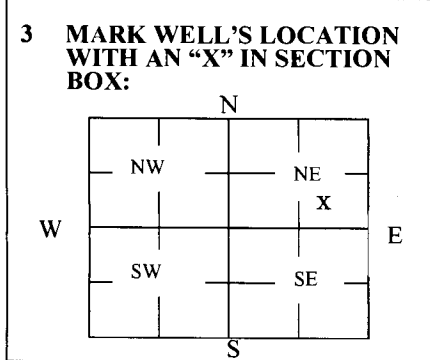

4 DEPTH OF WELL 17.45 T.O.C. ft.
 WELL'S STATIC WATER LEVEL NM ft
 WELL WAS USED AS:
 Domestic Public Water Supply Dewatering
 Irrigation Oil Field Water Supply Monitoring
 Feedlot Domestic (Lawn & Garden) Injection Well
 Industrial Air Conditioning Other _____
 Was a chemical/bacteriological sample submitted to Department? Yes No

5 TYPE OF BLANK CASING USED:

Steel RMP (SR) Wrought Fiberglass Other (Specify below)
 PVC ABS Asbestos-Cement Concrete Tile

Blank casing diameter 2 in. Was casing pulled? Yes No If yes, how much TOP 3 FEET BGS
 Casing height above or below land surface 36 in.

6 GROUT PLUG MATERIAL: Neat cement Cement grout Bentonite Other _____

Grout Plug Intervals: From 14.45 ft. to 3 ft., From _____ ft. to _____ ft., From _____ ft. to _____ ft.

What is the nearest source of possible contamination:
 Septic tank Seepage pit Fuel storage Other (specify below)
 Sewer lines Pit privy Fertilizer storage Historic stationary metals contamination
 Watertight sewer lines Sewage lagoon Insecticide storage
 Lateral lines Feedyard Abandoned water well Direction from well? Varied
 Cess pool Livestock pens Oil well/Gas well How many feet? Within 500

| FROM | TO | PLUGGING MATERIALS | FROM | TO | PLUGGING MATERIALS |
|------|-------|--------------------|------|----|--------------------|
| 0 | 3 | TOP SOIL | | | |
| 3 | 14.45 | BENTONITE GROUT | | | |
| | | | | | |
| | | | | | |
| | | | | | |
| | | | | | |

7 CONTRACTOR'S OR LANDOWNER'S CERTIFICATION: This water well was plugged under my jurisdiction and was completed on (mo/day/year) 03-07-18 and this record is true to the best of my knowledge and belief. Kansas Water Well Contractor's License No. 102. This Water Well Record was completed on (mo/day/year) 03/28/2018 under the business name of LAYNE CHRISTENSEN by (signature) Bob Christensen