


1 LOCATION OF WATER WELL:	Fraction	Section Number	Township Number	Range Number
County: Cherokee	SE ¼ NW ¼ SE ¼	26	T 32 S	R 22 E

Distance and direction from nearest town or city street address of well if located within city?

Hallowell Explosives Plant, Hallowell, Kansas

2 WATER WELL OWNER: Chemex 1 c/o Arcadis	Board of Agriculture, Division of Water Resources
RR#, St. Address, Box # : 8725 Rosehill, Suite 350	Application Number:
City, State, ZIP Code : Lenexa, Ks 66215	

3 LOCATE WELL'S LOCATION WITH AN "X" IN SECTION BOX:	4 DEPTH OF COMPLETED WELL
--	---------------------------

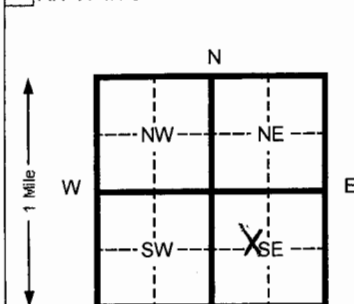

DEPTH OF COMPLETED WELL	17 ft.	ELEVATION:	
Depth(s) Groundwater Encountered	1 NA ft.	2	ft. 3
WELL'S STATIC WATER LEVEL	NA ft.	below land surface measured on mo/day/yr	
Pump test data:	Well water was	Ft. after	hours pumping
Est. Yield	Gpm: Well water was	Ft. after	Hours pumping
Bore Hole Diameter	8 in.	to	17 ft. and
WELL WATER TO BE USED AS:	5 Public water supply	8 Air conditioning	11 Injection well
1 Domestic	3 Feed lot	6 Oil field water supply	9 Dewatering
2 Irrigation	4 Industrial	7 Lawn and garden (domestic)	10 Monitoring well
			PT-3S
Was a chemical/bacteriological sample submitted to Department? Yes <input type="checkbox"/> No <input checked="" type="checkbox"/> If yes, mo/day/yr sample was Submitted			
Water Well Disinfected? Yes <input type="checkbox"/> No <input checked="" type="checkbox"/>			

5 TYPE OF BLANK CASING USED:	5 Wrought Iron	8 Concrete tile	CASING JOINTS: Glued	Clamped
1 Steel	3 RMP (SR)	6 Asbestos-Cement	9 Other (specify below)	Welded
2 PVC	4 ABS	7 Fiberglass		Threaded

Blank casing diameter	2 in.	to	12 Ft.	Dia	in.	to	ft.	Dia	in.	to	ft.
-----------------------	--------------	----	---------------	-----	-----	----	-----	-----	-----	----	-----

Casing height above land surface	FLUSH in.	weight	SCH 40 Lbs./ft.	Wall thickness or gauge No.
----------------------------------	------------------	--------	------------------------	-----------------------------

TYPE OF SCREEN OR PERFORATION MATERIAL:	7 PVC	10 Asbestos-cement
---	--------------	--------------------

1 Steel	3 Stainless steel	5 Fiberglass	8 RMP (SR)	11 Other (specify)
2 Brass	4 Galvanized steel	6 Concrete tile	9 ABS	12 None used (open hole)

SCREEN OR PERFORATION OPENINGS ARE:	5 Gauzed wrapped	8 Saw cut	11 None (open hole)
-------------------------------------	------------------	-----------	---------------------

1 Continuous slot	3 Mill slot	6 Wire wrapped	9 Drilled holes
2 Louvered shutter	4 Key punched	7 Torch cut	10 Other (specify)

SCREEN-PERFORATED INTERVALS:	From	12 ft.	to	17 ft.	From	ft.	to	ft.
------------------------------	------	---------------	----	---------------	------	-----	----	-----

SAND PACK INTERVALS:	From	11.5 ft.	to	12 ft.	From	ft.	to	ft.
----------------------	------	-----------------	----	---------------	------	-----	----	-----

From	ft.	to	ft.	From	ft.	to	ft.
------	-----	----	-----	------	-----	----	-----

From	ft.	to	ft.	From	ft.	to	ft.
------	-----	----	-----	------	-----	----	-----

From	ft.	to	ft.	From	ft.	to	ft.
------	-----	----	-----	------	-----	----	-----

6 GROUT MATERIAL:	1 Neat cement	2 Cement grout	3 Bentonite	4 Other
-------------------	---------------	----------------	--------------------	---------

GROUT INTERVALS	From	0 Ft.	to	10.5 Ft.	From	10.5 Ft.	to	11.5 ft.	From	ft.	to	ft.
-----------------	------	--------------	----	-----------------	------	-----------------	----	-----------------	------	-----	----	-----

What is the nearest source of possible contamination:	10 Livestock pens	14 Abandoned water well
---	-------------------	-------------------------

1 Septic tank	4 Lateral lines	7 Pit privy	11 Fuel storage	15 Oil well/ Gas well
---------------	-----------------	-------------	-----------------	-----------------------

2 Sewer lines	5 Cess pool	8 Sewage lagoon	12 Fertilizer storage	16 Other (specify below)
---------------	-------------	-----------------	-----------------------	--------------------------

3 Watertight sewer lines	6 Seepage pit	9 Feedyard	13 Insecticide storage	Contaminated Site
--------------------------	---------------	------------	------------------------	--------------------------

Direction from well?	How many feet?
----------------------	----------------

FROM	TO	CODE	LITHOLOGIC LOG	FROM	TO	PLUGGING INTERVALS
------	----	------	----------------	------	----	--------------------

0	17		Silty clay			
----------	-----------	--	-------------------	--	--	--

17	TD		End of Borhole			
-----------	-----------	--	-----------------------	--	--	--

--	--	--	--	--	--	--

--	--	--	--	--	--	--

7 CONTRACTOR'S OR LANDOWNER'S CERTIFICATION: This water well was (x) constructed, (2) reconstructed, or (3) plugged under my jurisdiction and w	Completed on (mo/day/yr) 06/09/04	And this record is true to the best of my knowledge and belief. Kansas
---	--	--

Water Well Contractor's License No. 585	This Water Well Record was completed on (mo/day/yr) 02/12/05
--	---

under the business name of Associated Environmental, Inc.	By (signature) Bradley J. Johnson
--	--

INSTRUCTIONS: Please fill in blanks and circle the correct answers. Send three copies to Kansas Department of Health and Environment, Bureau of Water, Topeka, Kansas 66620-0001. Telephone: 913-296-5545. Send one to WATER WELL OWNER and retain one for your records.
--

OFFICE USE ONLY

T

R

SEC