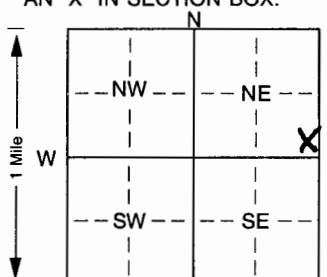


1] LOCATION OF WATER WELL: Fraction SE 1/4 SE 1/4 NE 1/4 Section Number 26 Township Number T 32 S Range Number R 22 E
 County: Cherokee

Distance and direction from nearest town or city street address of well if located within city?
Located in Mined Land Wildl. Area west of NW 70th, 1/2 mile N of New Louisa Rd

2] WATER WELL OWNER: Chemex I
 RR#, St. Address, Box #: 3600 NW 74th Board of Agriculture, Division of Water Resources
 City, State, ZIP Code: Columbus KS 66752 Application Number:

3] LOCATE WELL'S LOCATION WITH AN "X" IN SECTION BOX:

 4] DEPTH OF COMPLETED WELL: 19 ft. ELEVATION:
 Depth(s) Groundwater Encountered 1. 19 ft. 2. 0 ft. 3. 0 ft.
 WELL'S STATIC WATER LEVEL: Dry ft. below land surface measured on mo/day/yr # 3/2/06
 Pump test data: Well water was — ft. after — hours pumping — gpm
 Est. Yield — gpm: Well water was — ft. after — hours pumping — gpm
 Bore Hole Diameter: 8.5 in. to 19 ft., and — in. to — ft.
 WELL WATER TO BE USED AS:
 5 Public water supply 8 Air conditioning 11 Injection well
 1 Domestic 3 Feedlot 6 Oil field water supply 9 Dewatering 12 Other (Specify below)
 2 Irrigation 4 Industrial 7 Domestic (lawn & garden) 10 Monitoring well
 Was a chemical/bacteriological sample submitted to Department? Yes — No X; If yes, mo/day/yr sample was submitted
 Water Well Disinfected? Yes — No —

5] TYPE OF BLANK CASING USED:
 1 Steel 3 RMP (SR) 6 Asbestos-Cement 9 Other (specify below) Welded — Threaded X
2 PVC 4 ABS 7 Fiberglass
 Blank casing diameter 2 in. to 9 ft., Dia. — in. to — ft., Dia. — in. to — ft.
 Casing height above land surface 24 in., weight — lbs./ft. Wall thickness or gauge No. Sch 40
 TYPE OF SCREEN OR PERFORATION MATERIAL:
 1 Steel 3 Stainless steel 5 Fiberglass 8 RMP (SR) 10 Asbestos-cement
 2 Brass 4 Galvanized steel 6 Concrete tile 9 ABS 11 Other (specify) —
 12 None used (open hole)
 SCREEN OR PERFORATION OPENINGS ARE:
 1 Continuous slot 3 Mill slot 5 Gauzed wrapped 8 Saw cut 11 None (open hole)
 2 Louvered shutter 4 Key punched 6 Wire wrapped 9 Drilled holes
 7 Torch cut 10 Other (specify) — ft.
 SCREEN-PERFORATED INTERVALS: From 19 ft. to 9 ft., From — ft. to — ft.
 From — ft. to — ft., From — ft. to — ft.
 GRAVEL PACK INTERVALS: From 19 ft. to 8 ft., From — ft. to — ft.
 From — ft. to — ft., From — ft. to — ft.

6] GROUT MATERIAL: 1 Neat cement 2 Cement grout 3 Bentonite 4 Other —
 Grout Intervals: From 8 ft. to 2 ft., From — ft. to — ft., From — ft. to — ft.
 What is the nearest source of possible contamination:
 1 Septic tank 4 Lateral lines 7 Pit privy 10 Livestock pens 14 Abandoned water well
 2 Sewer lines 5 Cess pool 8 Sewage lagoon 11 Fuel storage 15 Oil well/Gas well
 3 Watertight sewer lines 6 Seepage pit 9 Feedyard 12 Fertilizer storage 16 Other (specify below) Factory
 13 Insecticide storage
 Direction from well? — How many feet? —

FROM	TO	LITHOLOGIC LOG	FROM	TO	PLUGGING INTERVALS
0	19	Silty Clay with Shale			

7] CONTRACTOR'S OR LANDOWNER'S CERTIFICATION: This water well was 1 constructed, (2) reconstructed, or (3) plugged under my jurisdiction and was completed on (mo/day/year) 3. 27. 06 and this record is true to the best of my knowledge and belief. Kansas Water Well Contractor's Licence No. 710 This Water Well Record was completed on (mo/day/yr) 4/12/06 under the business name of Below Ground Surface, Inc. by (signature) [Signature]