

GW 6

WATER WELL RECORD

Form WWC-5

Division of Water Resources App. No.


1 LOCATION OF WATER WELL: Fraction NE 1/4 NE 1/4 SW 1/4 1/4 Section Number 21 Township No. T 32 S Range Number R 22 E

County: Cherokee

Street/Rural Address of Well Location; if unknown, distance & direction from nearest town or intersection: If at owner's address, check here.  Attached map

Global Positioning System (GPS) information:  
 Latitude: 37.14 38.5 (in decimal degrees)  
 Longitude: 95.0 21.5 (in decimal degrees)  
 Elevation: 849  
 Datum:  WGS 84,  NAD 83,  NAD 27  
 Collection Method:  
 GPS unit (Make/Model: .....)  
 Digital Map/Photo,  Topographic Map,  Land Survey  
 Est. Accuracy:  <3 m,  3-5 m,  5-15 m,  >15 m

2 WATER WELL OWNER: Kyle Reames  
 RR#, Street Address, Box #: RR 3  
 City, State, ZIP Code: Columbus, KS 66725

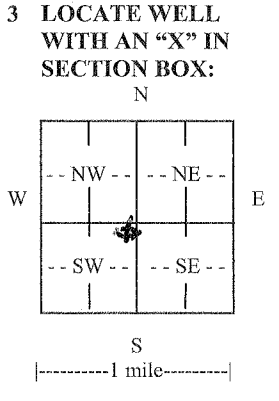

4 DEPTH OF COMPLETED WELL 60'4 ft.  
 Depth(s) Groundwater Encountered (1) 7' ft. (2)..... ft. (3)..... ft.  
 WELL'S STATIC WATER LEVEL.....ft. below land surface measured on mo/day/yr.....  
 Pump test data: Well water was.....ft. after..... hours pumping..... gpm  
 EST. YIELD.....gpm. Well water was.....ft. after..... hours pumping..... gpm  
 Bore Hole Diameter 6'4 in. to 60'4 ft., and .....in. to .....ft.  
 WELL WATER TO BE USED AS:  Public water supply  Geothermal  Injection well  
 Domestic  Feedlot  Oil field water supply  Dewatering  Other (Specify below)  
 Irrigation  Industrial  Domestic-lawn & garden  Monitoring well GW 6  
 Was a chemical/bacteriological sample submitted to Department?  Yes  No  
 If yes, mo/day/yr sample was submitted.....  
 Water well disinfected?  Yes  No

5 TYPE OF CASING USED:  Steel  PVC  Other .....  
 CASING JOINTS:  Glued  Clamped  Welded  Threaded  
 Casing diameter 2.6 in. to 33.4 ft., Diameter ..... in. to ..... ft., Diameter ..... in. to ..... ft.  
 Casing height above land surface 36' in., Weight ..... lbs./ft., Wall thickness or gauge No. Sch 40  
 TYPE OF SCREEN OR PERFORATION MATERIAL:  
 Steel  Stainless Steel  PVC  Other (Specify) X  
 Brass  Galvanized Steel  None used (open hole)  
 SCREEN OR PERFORATION OPENINGS ARE:  
 Continuous slot  Mill slot  Gauze wrapped  Torch cut  Drilled holes  None (open hole)  
 Louvered shutter  Key punched  Wire wrapped  Saw cut  Other (specify) .....  
 SCREEN-PERFORATED INTERVALS: From 60'4 ft. to 50'4 ft., From ..... ft. to ..... ft.  
 From ..... ft. to ..... ft., From ..... ft. to ..... ft.  
 GRAVEL PACK INTERVALS: From 60'4 ft. to 47' ft., From ..... ft. to ..... ft.  
 From ..... ft. to ..... ft., From ..... ft. to ..... ft.

6 GROUT MATERIAL:  Neat cement  Cement grout  Bentonite  Other .....  
 Grout Intervals: From 4.7 ft. to 1 ft., From ..... ft. to ..... ft., From ..... ft. to ..... ft.  
 What is the nearest source of possible contamination:  
 Septic tank  Lateral lines  Pit privy  Livestock pens  Insecticide storage  Other (specify below) Coal mine  
 Sewer lines  Cesspool  Sewage lagoon  Fuel storage  Abandoned water well  
 Watertight sewer lines  Seepage pit  Feedyard  Fertilizer storage  Oil well/gas well  
 Direction from well ..... Distance from well .....

FROM	TO	LITHOLOGIC LOG	FROM	TO	LITHO. LOG (cont.) or PLUGGING INTERVALS
0	3	Brn Clay			
3	11	Tan L.S			
11	20'3	Gray Shale			
20'3	21'1	Coal			
21'1	46'7	Gray Shale			
46'7	47	Coal			
47	55'3	Gray Shale			
55'3	56'8	Coal			
56'8	59'2	Gray Shale			
59'2	60'4	Gray L.S			

7 CONTRACTOR'S OR LANDOWNER'S CERTIFICATION: This water well was  constructed,  reconstructed, or  plugged under my jurisdiction and was completed on (mo/day/year) 1-18-12 and this record is true to the best of my knowledge and belief.  
 Kansas Water Well Contractor's License No. 704 This Water Well Record was completed on (mo/day/year) 2-1-12  
 under the business name of MAXS by (signature) David Douglas

INSTRUCTIONS: Use typewriter or ball point pen. PLEASE PRESS FIRMLY and PRINT clearly. Please fill in blanks and check the correct answers. Send three copies (white, blue, pink) to Kansas Department of Health and Environment, Bureau of Water, Geology Section, 1000 SW Jackson St., Suite 420, Topeka, Kansas 66612-1367. Telephone 785-296-5524. Send one copy to WATER WELL OWNER and retain one for your records. Include fee of \$5.00 for each constructed well. Visit us at <http://www.kdheks.gov/waterwell/index.html>.

SW-5

MISSOURI - KANSAS - TEXAS

R

I

D

A

N

829 T.M. EPLER

833 GW-1  
GW1A

THOMAS & MARILYN EPLER

839 ROBERT EPLER

850 GW-4  
GW4A

850

KYLE RENNE et al

850 GW-5  
GW5A

850 GW-6  
GW6A

850 GW-7  
GW7A

868 BETTY GUY

850 GW-8  
GW8A

21 SW-3

858 MAJINE GROVE

SW-6

GW-3  
GW3A

845 LEON

850 SW-4

28

GW-8

SW-11

846

850 SW-10

SW-7

835

823 KEVIN & ANTONETTE BEATTY

ARCHIE COBLE

850 DON OIL TRACT

850 ARCHIE COBLE

830

20

833

841

21

860

21

21

872

870

