WATER WELL RECORD — Form WWC-5

Division of Water Resources App. No. _____

1 LOCATION OF WATER WELL: County: Cherokee | Fraction: NW ¼ NW ¼ ¼ | Section Number: 28 | Township No. T 32 S | Range Number R 22 ☒E ☐W

Street/Rural Address of Well Location; if unknown, distance & direction from nearest town or intersection: If at owner's address, check here ☒.

Attached Map

Global Positioning System (GPS) information:
Latitude: 37° 14' 15" (in decimal degrees)
Longitude: 94° 59' 59" (in decimal degrees)
Elevation: 871
Datum: ☐ WGS 84, ☒ NAD 83, ☐ NAD 27
Collection Method:
☐ GPS unit (Make/Model: .....)
☒ Digital Map/Photo, ☐ Topographic Map, ☐ Land Survey
Est. Accuracy: ☐ <3 m, ☒ 3-5 m, ☐ 5-15 m, ☐ >15 m

2 WATER WELL OWNER: Kyle Rennie
RR#, Street Address, Box #: RR3
City, State, ZIP Code: Columbus, Ks 66725

3 LOCATE WELL WITH AN "X" IN SECTION BOX:

N / W / E / S; NW, NE, SW, SE; |----------1 mile----------|

4 DEPTH OF COMPLETED WELL 68' ft.
Depth(s) Groundwater Encountered (1) 14 ft. (2) ..... ft. (3) ..... ft.
WELL'S STATIC WATER LEVEL ..... ft. below land surface measured on mo/day/yr .....
Pump test data: Well water was ..... ft. after ..... hours pumping ..... gpm
EST. YIELD ..... gpm. Well water was ..... ft. after ..... hours pumping ..... gpm
Bore Hole Diameter 3.5 in. to 68 ft., and ..... in. to ..... ft.
WELL WATER TO BE USED AS: ☐ Public water supply ☐ Geothermal ☐ Injection well
☐ Domestic ☐ Feedlot ☐ Oil field water supply ☐ Dewatering ☐ Other (Specify below)
☐ Irrigation ☐ Industrial ☐ Domestic-lawn & garden ☐ Monitoring well CaW-7A
Was a chemical/bacteriological sample submitted to Department? ☐ Yes ☒ No Piezometer
If yes, mo/day/yr sample was submitted .....
Water well disinfected? ☐ Yes ☒ No

5 TYPE OF CASING USED: ☐ Steel ☒ PVC ☐ Other .....
CASING JOINTS: ☐ Glued ☐ Clamped ☐ Welded ☒ Threaded
Casing diameter 2 in. to 61 ft., Diameter ..... in. to ..... ft., Diameter ..... in. to ..... ft.
Casing height above land surface 36 in., Weight ..... lbs./ft., Wall thickness or gauge No. Sch 40
TYPE OF SCREEN OR PERFORATION MATERIAL:
☐ Steel ☐ Stainless Steel ☒ PVC ☐ Other (Specify) .....
☐ Brass ☐ Galvanized Steel ☐ None used (open hole)
SCREEN OR PERFORATION OPENINGS ARE:
☐ Continuous slot ☒ Mill slot ☐ Gauze wrapped ☐ Torch cut ☐ Drilled holes ☐ None (open hole)
☐ Louvered shutter ☐ Key punched ☐ Wire wrapped ☐ Saw cut ☐ Other (specify) .....
SCREEN-PERFORATED INTERVALS: From 68 ft. to 58 ft., From ..... ft. to ..... ft.
From ..... ft. to ..... ft., From ..... ft. to ..... ft.
GRAVEL PACK INTERVALS: From 68 ft. to 55 ft., From ..... ft. to ..... ft.
From ..... ft. to ..... ft., From ..... ft. to ..... ft.

6 GROUT MATERIAL: ☐ Neat cement ☐ Cement grout ☒ Bentonite ☐ Other .....
Grout Intervals: From 55 ft. to 1 ft., From ..... ft. to ..... ft., From ..... ft. to ..... ft.
What is the nearest source of possible contamination:
☐ Septic tank ☐ Lateral lines ☐ Pit privy ☐ Livestock pens ☐ Insecticide storage ☒ Other (specify below)
☐ Sewer lines ☐ Cesspool ☐ Sewage lagoon ☐ Fuel storage ☐ Abandoned water well Coal mine
☐ Watertight sewer lines ☐ Seepage pit ☐ Feedyard ☐ Fertilizer storage ☐ Oil well/gas well
Direction from well ..... Distance from well .....

FROM	TO	LITHOLOGIC LOG	FROM	TO	LITHO. LOG (cont.) or PLUGGING INTERVALS
0	10.5	Brn Clay			
10.5	14	Tan L.S			
14	25.2	Gray Shale			
25.2	26.1	Coal			
26.1	40.7	Gray Shale			
40.7	42.7	Gray L.S			
42.7	64.2	Gray Shale			
64.2	65.7	Coal			
65.7	66.9	Gray Fire Clay			
66.9	68	Gray Shale			

7 CONTRACTOR'S OR LANDOWNER'S CERTIFICATION: This water well was ☒ constructed, ☐ reconstructed, or ☐ plugged under my jurisdiction and was completed on (mo/day/year) 8-12-11 and this record is true to the best of my knowledge and belief. Kansas Water Well Contractor's License No. 704. This Water Well Record was completed on (mo/day/year) 8-17-12 under the business name of MAXS by (signature) [signature]

INSTRUCTIONS: Use typewriter or ball point pen. *PLEASE PRESS FIRMLY* and *PRINT* clearly. Please fill in blanks and check the correct answers. Send three copies (white, blue, pink) to Kansas Department of Health and Environment, Bureau of Water, Geology Section, 1000 SW Jackson St., Suite 420, Topeka, Kansas 66612-1367. Telephone 785-296-5524. Send one copy to WATER WELL OWNER and retain one for your records. Include fee of $5.00 for each constructed well. Visit us at http://www.kdheks.gov/waterwell/index.html.

KSA 82a-1212

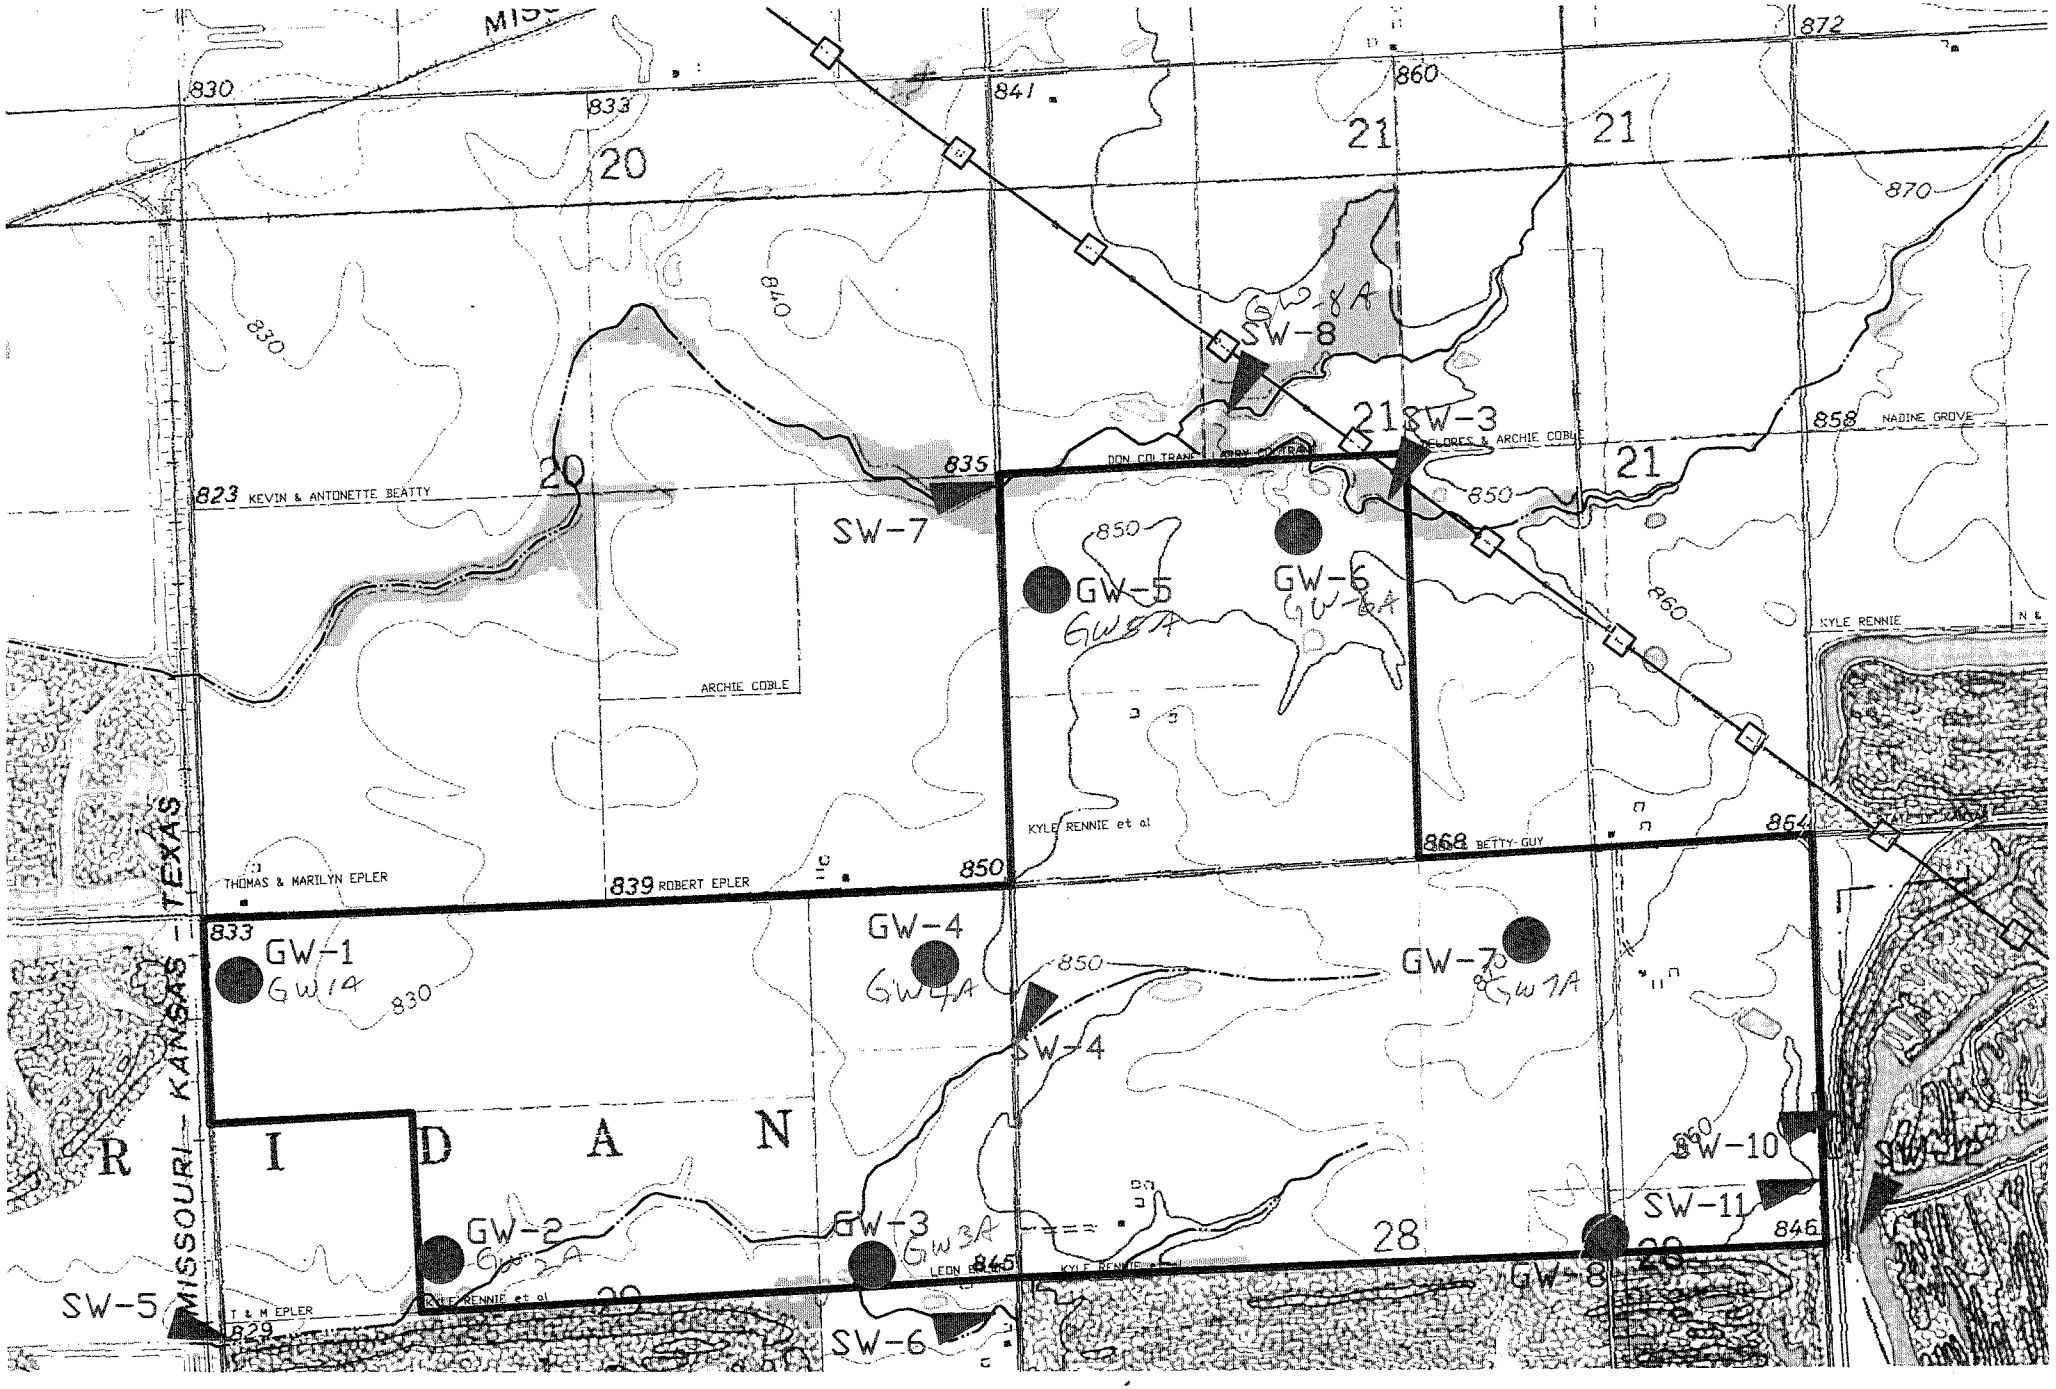
MISSOURI - KANSAS TEXAS
R I D A N
SW-1
SW-2
SW-3
SW-4
SW-5
SW-6
SW-7
SW-8
SW-10
SW-11
GW-1
GW-2
GW-3
GW-4
GW-5
GW-6
GW-7
GW-8
GW1A
GW2A
GW3A
GW4A
GW5A
GW6A
GW7A
GW8A
20
21
28
29
830
833
835
840
841
846
845
850
858
860
864
868
870
872
823 KEVIN & ANTONETTE BEATTY
839 ROBERT EPLER
THOMAS & MARILYN EPLER
ARCHIE COBLE
KYLE RENNIE et al
KYLE RENNIE
868 BETTY GUY
858 NADINE GROVE
DELORES & ARCHIE COBLE
T & M EPLER
LEON