GW 3

WATER WELL RECORD Form WWC-5

Division of Water Resources App. No.

1 LOCATION OF WATER WELL: County: Cherokee | Fraction: SW¼ SE¼ NE¼ ¼ | Section Number: 29 | Township No.: T 32 S | Range Number: R 22 ☒E ☐W

Street/Rural Address of Well Location; if unknown, distance & direction from nearest town or intersection: If at owner's address, check here ☒

Attached Map

Global Positioning System (GPS) information:
Latitude: 37 13m 50s (in decimal degrees)
Longitude: 95 1m 15 (in decimal degrees)
Elevation: 838
Datum: ☐ WGS 84, ☒ NAD 83, ☐ NAD 27
Collection Method:
☐ GPS unit (Make/Model: .....)
☒ Digital Map/Photo, ☐ Topographic Map, ☐ Land Survey
Est. Accuracy: ☒ <3 m, ☐ 3-5 m, ☐ 5-15 m, ☐ >15 m

2 WATER WELL OWNER: Kyle Remes
RR#, Street Address, Box #: RR3
City, State, ZIP Code: Columbus, Ks 66725

3 LOCATE WELL WITH AN "X" IN SECTION BOX:

N / W / E / S — NW, NE, SW, SE — |----------1 mile---------|

4 DEPTH OF COMPLETED WELL 55 ft.
Depth(s) Groundwater Encountered (1) 20' ft. (2) ..... ft. (3) ..... ft.
WELL'S STATIC WATER LEVEL ..... ft. below land surface measured on mo/day/yr .....
Pump test data: Well water was ..... ft. after ..... hours pumping ..... gpm
EST. YIELD ..... gpm. Well water was ..... ft. after ..... hours pumping ..... gpm
Bore Hole Diameter 6¼ in. to 55 ft., and ..... in. to ..... ft.
WELL WATER TO BE USED AS: ☐ Public water supply ☐ Geothermal ☐ Injection well
☐ Domestic ☐ Feedlot ☐ Oil field water supply ☐ Dewatering ☐ Other (Specify below)
☐ Irrigation ☐ Industrial ☐ Domestic-lawn & garden ☒ Monitoring well GW 3
Was a chemical/bacteriological sample submitted to Department? ☐ Yes ☒ No
If yes, mo/day/yr sample was submitted .....
Water well disinfected? ☐ Yes ☒ No

5 TYPE OF CASING USED: ☐ Steel ☒ PVC ☐ Other .....
CASING JOINTS: ☐ Glued ☐ Clamped ☐ Welded ☒ Threaded
Casing diameter 2" in. to 48' ft., Diameter ..... in. to ..... ft., Diameter ..... in. to ..... ft.
Casing height above land surface 36 in., Weight ..... lbs./ft., Wall thickness or gauge No. Sch 40
TYPE OF SCREEN OR PERFORATION MATERIAL:
☐ Steel ☐ Stainless Steel ☒ PVC ☐ Other (Specify) .....
☐ Brass ☐ Galvanized Steel ☐ None used (open hole)
SCREEN OR PERFORATION OPENINGS ARE:
☐ Continuous slot ☒ Mill slot ☐ Gauze wrapped ☐ Torch cut ☐ Drilled holes ☐ None (open hole)
☐ Louvered shutter ☐ Key punched ☐ Wire wrapped ☐ Saw cut ☐ Other (specify) .....
SCREEN-PERFORATED INTERVALS: From 55' ft. to 45' ft., From ..... ft. to ..... ft.
From ..... ft. to ..... ft., From ..... ft. to ..... ft.
GRAVEL PACK INTERVALS: From 55' ft. to 42' ft., From ..... ft. to ..... ft.
From ..... ft. to ..... ft., From ..... ft. to ..... ft.

6 GROUT MATERIAL: ☐ Neat cement ☐ Cement grout ☒ Bentonite ☐ Other .....
Grout Intervals: From 42' ft. to 1' ft., From ..... ft. to ..... ft., From ..... ft. to ..... ft.
What is the nearest source of possible contamination:
☐ Septic tank ☐ Lateral lines ☐ Pit privy ☐ Livestock pens ☐ Insecticide storage ☒ Other (specify below)
☐ Sewer lines ☐ Cesspool ☐ Sewage lagoon ☐ Fuel storage ☐ Abandoned water well
☐ Watertight sewer lines ☐ Seepage pit ☐ Feedyard ☐ Fertilizer storage ☐ Oil well/gas well
Direction from well ..... Distance from well .....

FROM	TO	LITHOLOGIC LOG	FROM	TO	LITHO. LOG (cont.) or PLUGGING INTERVALS
0	19½	Brn Clay			
19½	29'	Gray shale weather			
29½	31'	Gray Shale			
29½	31	Coal			
31	50.9	Gray Shale			
50.9	52.3	Coal			
52.3	55	Gray Shale & L.S			

7 CONTRACTOR'S OR LANDOWNER'S CERTIFICATION: This water well was ☒ constructed, ☐ reconstructed, or ☐ plugged under my jurisdiction and was completed on (mo/day/year) 1-9-10 and this record is true to the best of my knowledge and belief. Kansas Water Well Contractor's License No. 704 This Water Well Record was completed on (mo/day/year) 2-1-12 under the business name of MAXS by (signature) David Bunyo

INSTRUCTIONS: Use typewriter or ball point pen. *PLEASE PRESS FIRMLY* and *PRINT* clearly. Please fill in blanks and check the correct answers. Send three copies (white, blue, pink) to Kansas Department of Health and Environment, Bureau of Water, Geology Section, 1000 SW Jackson St., Suite 420, Topeka, Kansas 66612-1367. Telephone 785-296-5524. Send one copy to WATER WELL OWNER and retain one for your records. Include fee of $5.00 for each constructed well. Visit us at http://www.kdheks.gov/waterwell/index.html.

KSA 82a-1212

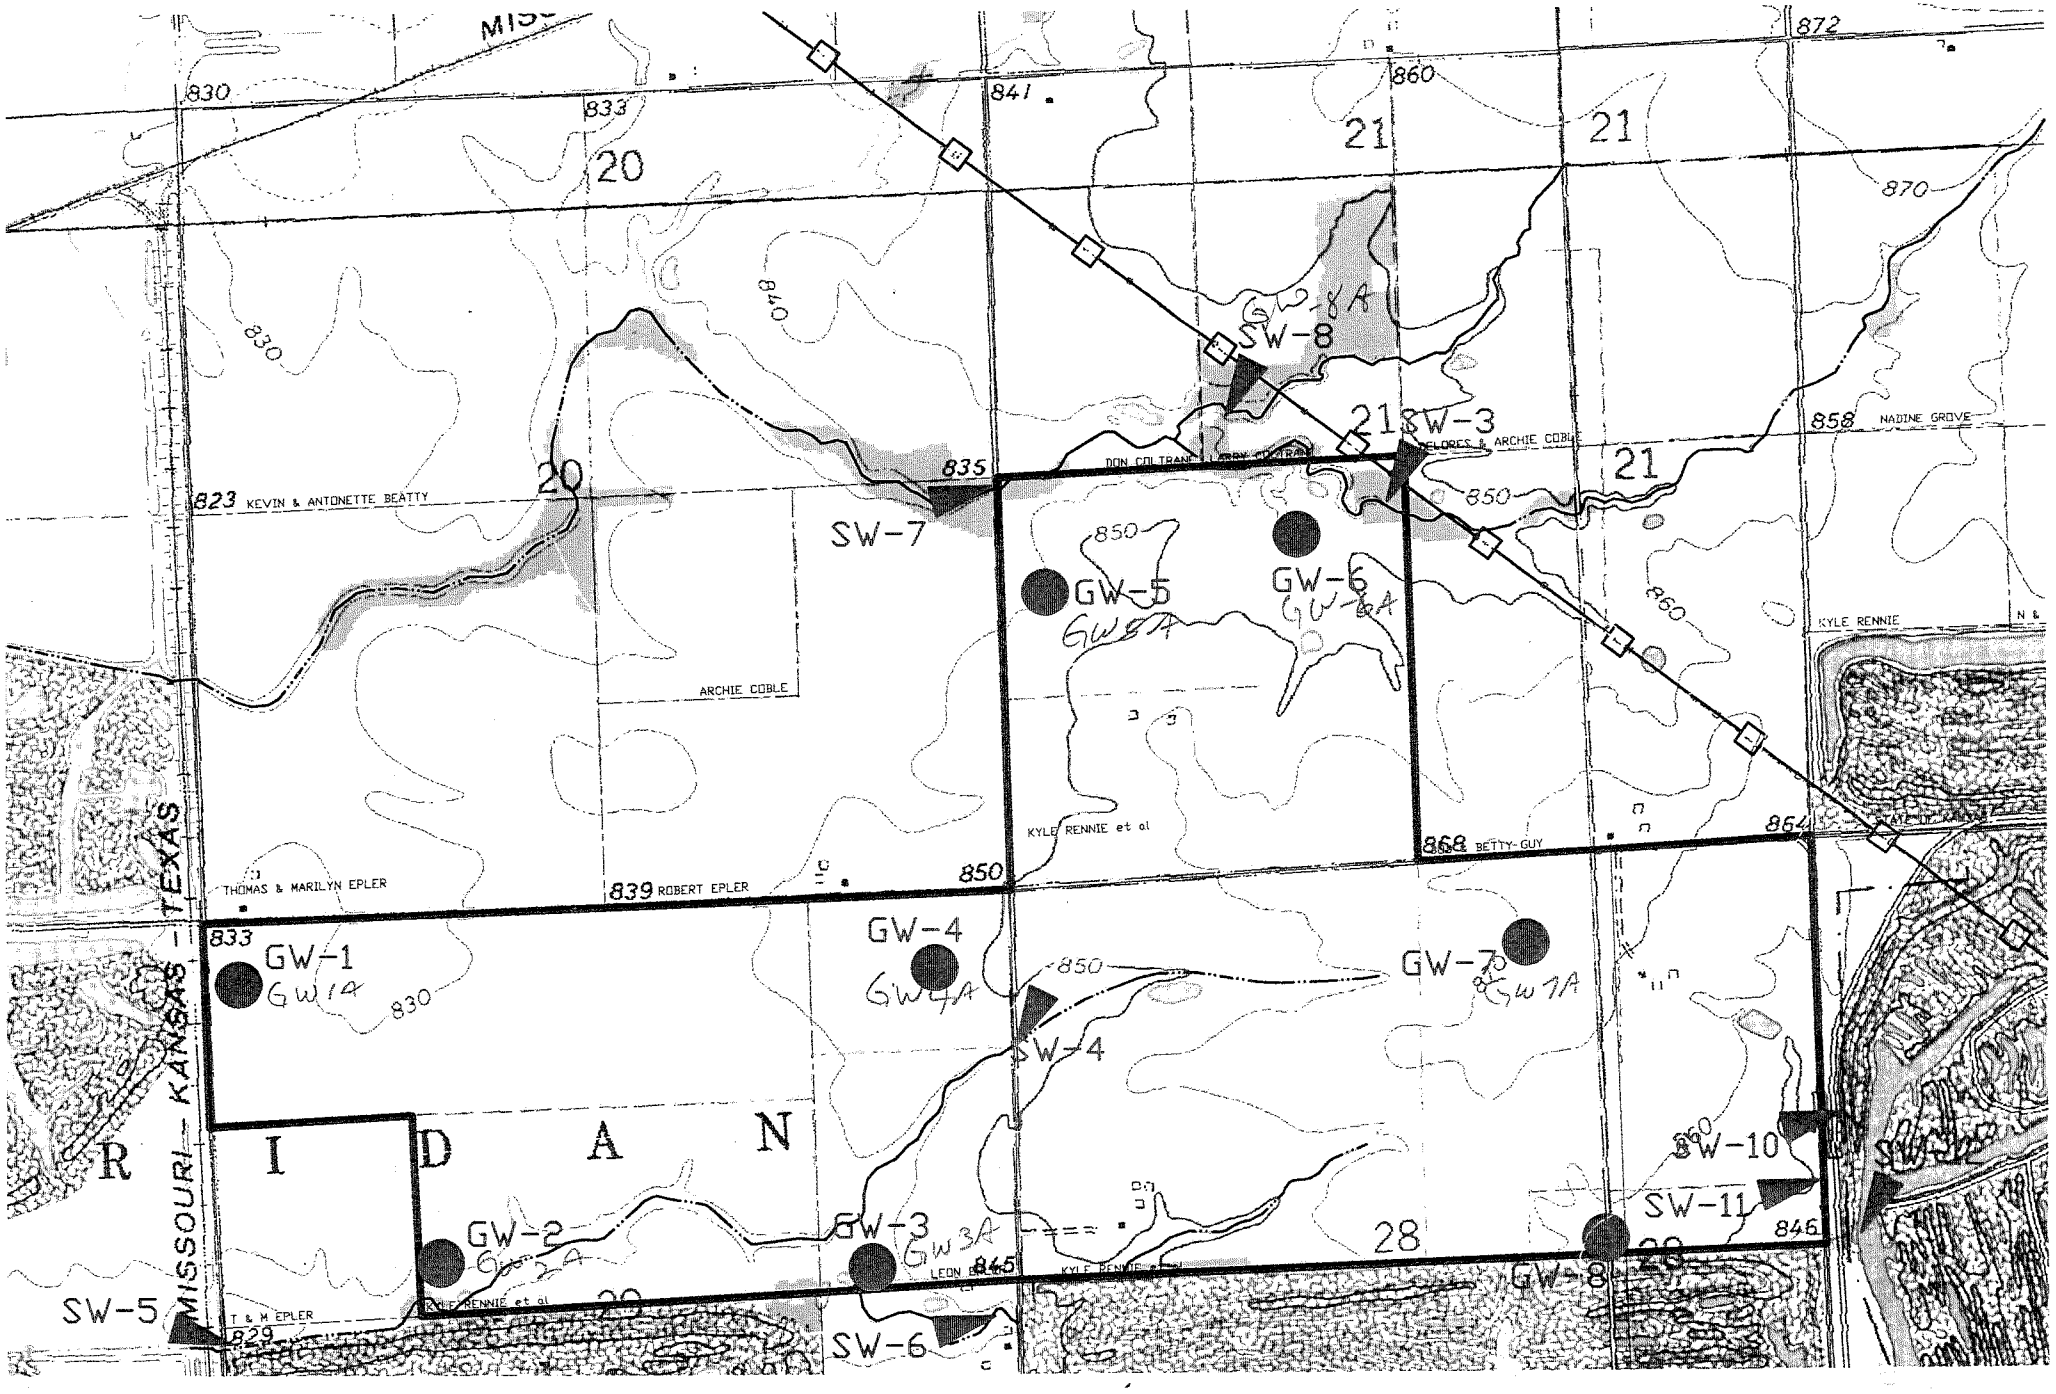
MISSOURI – KANSAS – TEXAS
R I D A N
20
21
28
29
SW-1
SW-2
SW-3
SW-4
SW-5
SW-6
SW-7
SW-8
SW-10
SW-11
GW-1
GW-2
GW-3
GW-4
GW-5
GW-6
GW-7
GW-8
GW1A
GW2A
GW2-8A
GW3A
GW4A
GW5A
GW6A
GW7A
ARCHIE COBLE
KYLE RENNIE et al
KYLE RENNIE
NADINE GROVE
BETTY-GUY
ROBERT EPLER
THOMAS & MARILYN EPLER
T & M EPLER
KEVIN & ANTONETTE BEATTY
DELORES & ARCHIE COBLE
LEON
830
833
835
839
841
845
846
850
858
860
864
868
870
872