WATER WELL RECORD Form WWC-5 KSA 82a-1212 MW-3 02938008

1 LOCATION OF WATER WELL:	Fraction	Section Number	Township Number	Range Number
County: Cherokee	SW ¼ SW ¼ NE ¼	30	T 32 S	R 24 E W

Distance and direction from nearest town or city street address of well if located within city?
4 miles North of Columbus Ks on HWY 7

2 WATER WELL OWNER: Wheatland Sanitary Landfill
RR#, St. Address, Box # : P.O Box 306
City, State, ZIP Code : Columbus Ks 66725
Board of Agriculture, Division of Water Resources
Application Number:

3 LOCATE WELL'S LOCATION WITH AN "X" IN SECTION BOX:

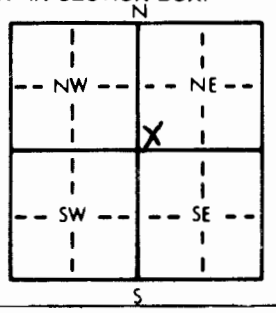

4 DEPTH OF COMPLETED WELL 37.5 ft. ELEVATION: —
Depth(s) Groundwater Encountered 1. 31.0 ft. 2. — ft. 3. — ft.
WELL'S STATIC WATER LEVEL — ft. below land surface measured on mo/day/yr —
Pump test data: Well water was — ft. after — hours pumping — gpm
Est. Yield — gpm: Well water was — ft. after — hours pumping — gpm
Bore Hole Diameter 7 1/4 in. to 37.5 ft., and — in. to — ft.
WELL WATER TO BE USED AS: 5 Public water supply 8 Air conditioning 11 Injection well
1 Domestic 3 Feedlot 6 Oil field water supply 9 Dewatering 12 Other (Specify below)
2 Irrigation 4 Industrial 7 Lawn and garden only (10) Monitoring well
Was a chemical/bacteriological sample submitted to Department? Yes ..... No X ; If yes, mo/day/yr sample was submitted
Water Well Disinfected? Yes No X

5 TYPE OF BLANK CASING USED: 5 Wrought iron 8 Concrete tile CASING JOINTS: Glued Clamped
1 Steel 3 RMP (SR) 6 Asbestos-Cement 9 Other (specify below) Welded
2 PVC 4 ABS 7 Fiberglass Threaded X
Blank casing diameter 2 in. to 36.7 ft., Dia — in. to — ft., Dia — in. to — ft.
Casing height above land surface 2-3 in., weight Sch 40 lbs./ft. Wall thickness or gauge No. —

TYPE OF SCREEN OR PERFORATION MATERIAL: (7) PVC 10 Asbestos-cement
1 Steel 3 Stainless steel 5 Fiberglass 8 RMP (SR) 11 Other (specify)
2 Brass 4 Galvanized steel 6 Concrete tile 9 ABS 12 None used (open hole)

SCREEN OR PERFORATION OPENINGS ARE: 5 Gauzed wrapped 8 Saw cut 11 None (open hole)
1 Continuous slot (3) Mill slot 6 Wire wrapped 9 Drilled holes
2 Louvered shutter 4 Key punched 7 Torch cut 10 Other (specify)

SCREEN-PERFORATED INTERVALS: From 36.7 ft. to 35.7 ft., From — ft. to — ft.
From — ft. to — ft., From — ft. to — ft.
GRAVEL PACK INTERVALS: From 23.3 ft. to 37.5 ft., From — ft. to — ft.
From — ft. to — ft., From — ft. to — ft.

6 GROUT MATERIAL: (1) Neat cement 2 Cement grout (3) Bentonite 4 Other —
Grout Intervals: From 0-0 ft. to 23.3 ft., From — ft. to — ft., From — ft. to — ft.

What is the nearest source of possible contamination:
1 Septic tank 4 Lateral lines 7 Pit privy 10 Livestock pens 14 Abandoned water well
2 Sewer lines 5 Cess pool 8 Sewage lagoon 11 Fuel storage 15 Oil well/Gas well
3 Watertight sewer lines 6 Seepage pit 9 Feedyard 12 Fertilizer storage (16) Other (specify below)
13 Insecticide storage Landfill
Direction from well? How many feet?

FROM	TO	LITHOLOGIC LOG	FROM	TO	PLUGGING INTERVALS
0.0	.6s	Topsoil			
.6s	1.3	Clay Fat DK Br			
1.3	3.0	clay Fat tr sa Gr Org			
3.0	8.3	clay Fat Gr Org			
8.3	8.6	sa clay Fat w/sis Frag Gr Org			
8.6	22.8	Gr Or silt stone			
22.8	27.4	Sa Shale Gr			
27.4	28.7	Sa stone Gr.			
28.7	31.5	Coal Black Ol yell			
31.5	32.3	Blk coal			
32.3	35.5	Blk coal			
35.5	37.5	shale Gray			

7 CONTRACTOR'S OR LANDOWNER'S CERTIFICATION: This water well was (1) constructed, (2) reconstructed, or (3) plugged under my jurisdiction and was completed on (mo/day/year) 7/28/93 and this record is true to the best of my knowledge and belief. Kansas Water Well Contractor's License No. 416 This Water Well Record was completed on (mo/day/yr) 8/6/93 under the business name of Terracon Consultants Inc by (signature) Richard D Murray

INSTRUCTIONS: Use typewriter or ball point pen. *PLEASE PRESS FIRMLY* and *PRINT* clearly. Please fill in blanks, underline or circle the correct answers. Send top three copies to Kansas Department of Health and Environment, Bureau of Water, Topeka, Kansas 66620-7320. Telephone: 913-296-5545. Send one to WATER WELL OWNER and retain one for your records.

OFFICE USE ONLY T R E/W SEC. ¼ ¼ ¼