

WATER WELL RECORD

Form WWC-5


Division of Water Resources App. No.

48174

1 LOCATION OF WATER WELL: County: Cowley Fraction NE 1/4 SW 1/4 SE 1/4 NW 1/4 Section Number 34 Township No. T 32 S Range Number R 3 [X]E []W

Street/Rural Address of Well Location; if unknown, distance & direction from nearest town or intersection: If at owner's address, check here []. From Winfield 4W 1S 3/4W SSR 1/4 mile in field Global Positioning System (GPS) information: Latitude: .37,22472 (in decimal degrees) Longitude: 097.09076 (in decimal degrees) Elevation: 1153 Datum: [] WGS 84, [] NAD 83, [X] NAD 27 Collection Method: [X] GPS unit (Make/Model: Garmin 62S) [] Digital Map/Photo, [X] Topographic Map, [] Land Survey Est. Accuracy: [] <3 m, [X] 3-5 m, [] 5-15 m, [] >15 m

2 WATER WELL OWNER: Brian Priest RR#, Street Address, Box #: 7497 192nd Road City, State, ZIP Code : Winfield, Kansas 67156

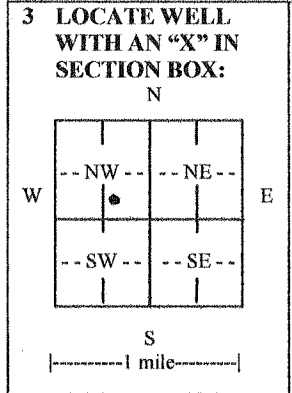

3 LOCATE WELL WITH AN "X" IN SECTION BOX: N W E S |-----1 mile-----| 4 DEPTH OF COMPLETED WELL 33 ft. Depth(s) Groundwater Encountered (1)..... ft. (2)..... ft. (3)..... ft. WELL'S STATIC WATER LEVEL 9 ft. below land surface measured on mo/day/yr. 6/19/2014 Pump test data: Well water was.....ft. after..... hours pumping..... gpm EST. YIELD.....gpm. Well water was.....ft. after..... hours pumping..... gpm Bore Hole Diameter 20.....in. to 33.....ft., andin. toft. WELL WATER TO BE USED AS: [] Public water supply [] Geothermal [] Injection well [] Domestic [] Feedlot [] Oil field water supply [] Dewatering [] Other (Specify below) [X] Irrigation [] Industrial [] Domestic-lawn & garden [] Monitoring well Was a chemical/bacteriological sample submitted to Department? [] Yes [X] No If yes, mo/day/yr sample was submitted..... Water well disinfected? [X] Yes [] No

5 TYPE OF CASING USED: [] Steel [X] PVC [] Other CASING JOINTS: [X] Glued [] Clamped [] Welded [] Threaded Bolted Casing diameter .12..... in. to .23..... ft., Diameter in. to ft., Diameter in. to ft. Casing height above land surface..24..... in., Weight SCH40.....lbs./ft., Wall thickness or gauge No. 406 TYPE OF SCREEN OR PERFORATION MATERIAL: [] Steel [X] Stainless Steel [X] PVC [] Brass [] Galvanized Steel [] None used (open hole) [] Other (Specify) SCREEN OR PERFORATION OPENINGS ARE: [] Continuous slot [] Mill slot [] Gauze wrapped [] Torch cut [] Drilled holes [] None (open hole) [] Louvered shutter [] Key punched [X] Wire wrapped [] Saw cut [] Other (specify) SCREEN-PERFORATED INTERVALS: From .23..... ft. to .33..... ft., From ft. to ft. From ft. to ft., From ft. to ft. GRAVEL PACK INTERVALS: From .33..... ft. to .15..... ft., From ft. to ft. From ft. to ft., From ft. to ft.

6 GROUT MATERIAL: [] Neat cement [] Cement grout [X] Bentonite [] Other Grout Intervals: From .15..... ft. to .0..... ft., From ft. to ft., From ft. to ft., From ft. to ft. What is the nearest source of possible contamination: [] Septic tank [] Lateral lines [] Pit privy [] Livestock pens [] Insecticide storage [X] Other (specify below) [] Sewer lines [] Cesspool [] Sewage lagoon [] Fuel storage [] Abandoned water well [] Watertight sewer lines [] Seepage pit [] Feedyard [] Fertilizer storage [] Oil well/gas well n/a Direction from well Distance from well

FROM	TO	LITHOLOGIC LOG	FROM	TO	LITHO. LOG (cont.) or PLUGGING INTERVALS
0	3	Top soil			
3	11	Light tan clay			
11	17	Fine small sand			
17	20	Small sand & light gray clay 80/20			
20	25	Small-fine sand			
25	31	Small sand loose			
31	33	Shale			

7 CONTRACTOR'S OR LANDOWNER'S CERTIFICATION: This water well was [X] constructed, [] reconstructed, or [] plugged under my jurisdiction and was completed on (mo/day/year) 6/19/2014 and this record is true to the best of my knowledge and belief. Kansas Water Well Contractor's License No. 134..... This Water Well Record was completed on (mo/day/year) 7/15/2014 under the business name of .Rosencrantz-Bemis Ent. by (signature) [Signature]

INSTRUCTIONS: Use typewriter or ball point pen. PLEASE PRESS FIRMLY and PRINT clearly. Please fill in blanks and check the correct answers. Send three copies (white, blue, pink) to Kansas Department of Health and Environment, Bureau of Water, Geology Section, 1000 SW Jackson St., Suite 420, Topeka, Kansas 66612-1367. Telephone 785-296-5524. Send one copy to WATER WELL OWNER and retain one for your records. Include fee of \$5.00 for each constructed well. Visit us at http://www.kdheks.gov/waterwell/index.html.