


1 LOCATION OF WATER WELL: Fraction SW 1/4 SW 1/4 SE 1/4 Section Number 2 Township Number T 32 S Range Number R 3 **EW**
 County: Cowley

Distance and direction from nearest town or city street address of well if located within city?
3 M. North on Hway 77 - 2 1/2 M. West on CC 18 from Winfield

2 WATER WELL OWNER: Arthur Rahn
 RR#, St. Address, Box # : 1014 Thompson Board of Agriculture, Division of Water Resources
 City, State, ZIP Code : Winfield, Kansas 67156 Application Number:

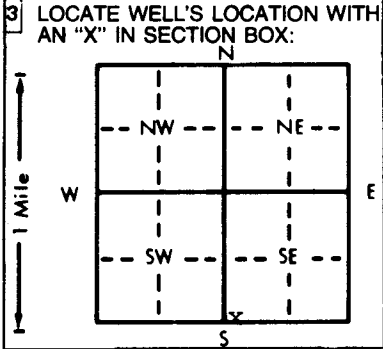

4 DEPTH OF COMPLETED WELL... 60... ft. ELEVATION: Unk....
 Depth(s) Groundwater Encountered 1. 53... ft. 2. ft. 3. ft.
 WELL'S STATIC WATER LEVEL 40... ft. below land surface measured on mo/day/yr 10/8/88...
 Pump test data: Well water was 55... ft. after 1 1/4... hours pumping 15... gpm
 Est. Yield 12/15... gpm: Well water was ... ft. after ... hours pumping ... gpm
 Bore Hole Diameter... 8... in. to T.D.... ft., and... in. to ... ft.
 WELL WATER TO BE USED AS: 5 Public water supply 8 Air conditioning 11 Injection well
1 Domestic 3 Feedlot 6 Oil field water supply 9 Dewatering 12 Other (Specify below)
 2 Irrigation 4 Industrial 7 Lawn and garden only 10 Monitoring well
 Was a chemical/bacteriological sample submitted to Department? Yes.....No...X.....; If yes, mo/day/yr sample was sub-
 mitted Water Well Disinfected? Yes X No

5 TYPE OF BLANK CASING USED: 5 Wrought iron 8 Concrete tile CASING JOINTS: Glued X Clamped.....
 1 Steel 3 RMP (SR) 6 Asbestos-Cement 9 Other (specify below) Welded.....
 2 PVC 4 ABS 7 Fiberglass Threaded.....
 Blank casing diameter 5... in. to T.D.... ft., Dia... in. to ... ft., Dia... in. to ... ft.
 Casing height above land surface 24... in., weight 160# psi... lbs./ft. Wall thickness or gauge No. SDR 26...
 TYPE OF SCREEN OR PERFORATION MATERIAL: 7 PVC 10 Asbestos-cement
 1 Steel 3 Stainless steel 5 Fiberglass 8 RMP (SR) 11 Other (specify).....
 2 Brass 4 Galvanized steel 6 Concrete tile 9 ABS 12 None used (open hole)
 SCREEN OR PERFORATION OPENINGS ARE: 5 Gauzed wrapped 8 Saw cut 11 None (open hole)
 1 Continuous slot 3 Mill slot 6 Wire wrapped 9 Drilled holes
 2 Louvered shutter 4 Key punched 7 Torch cut 10 Other (specify).....
 SCREEN-PERFORATED INTERVALS: From 55... ft. to 60... ft., From ... ft. to ... ft.
 From ... ft. to ... ft., From ... ft. to ... ft.
 GRAVEL PACK INTERVALS: From 25... ft. to 60... ft., From ... ft. to ... ft.
 From ... ft. to ... ft., From ... ft. to ... ft.

6 GROUT MATERIAL: 1 Neat cement 2 Cement grout 3 Bentonite 4 Other.....
 Grout Intervals: From 3... ft. to 25... ft., From ... ft. to ... ft., From ... ft. to ... ft.
 What is the nearest source of possible contamination: 10 Livestock pens 14 Abandoned water well
 1 Septic tank 4 Lateral lines 7 Pit privy 11 Fuel storage 15 Oil well/Gas well
 2 Sewer lines 5 Cess pool 8 Sewage lagoon 12 Fertilizer storage 16 Other (specify below)
 3 Watertight sewer lines 6 Seepage pit 9 Feedyard 13 Insecticide storage
 Direction from well? SE How many feet? 250

FROM	TO	LITHOLOGIC LOG	FROM	TO	PLUGGING INTERVALS
0	3	Top soil			
3	12	Clay			
12	26	Wht. lm med.			
26	45	Shale / shelly lm			
45	53	lm blu gry med.			
53	60	Brkn. lm / multi colored sh (water)			

7 CONTRACTOR'S OR LANDOWNER'S CERTIFICATION: This water well was (1) constructed, (2) reconstructed, or (3) plugged under my jurisdiction and was completed on (mo/day/year) 10/10/88 and this record is true to the best of my knowledge and belief. Kansas Water Well Contractor's License No. 171 This Water Well Record was completed on (mo/day/yr) 11/4/88 under the business name of G & S Drilling by (signature) [Signature]

INSTRUCTIONS: Use typewriter or ball point pen. PLEASE PRESS FIRMLY and PRINT clearly. Please fill in blanks, underline or circle the correct answers. Send top three copies to Kansas Department of Health and Environment, Bureau of Water Protection, Topeka, Kansas 66620-7320. Telephone: 913-296-5514. Send one to WATER WELL OWNER and retain one for your records.

28-8800000088-82

OFFICE USE ONLY
T
R
EW
SEC.
1/4
1/4
1/4