USE TYPEWRITER OR BALL POINT PEN-PRESS FIRMLY, PRINT CLEARLY.

WATER WELL RECORD
KSA 82a-1201-1215

Kansas Department of Health and Environment-Division of Environment
(Water well Contractors)
Topeka, Kansas 66620

1. Location of well:	County	Fraction	Section number	Township number	Range number
	Cowley	SW 1/4 NE 1/4 SW 1/4	12	T 32 S	R 3 (E) W

2. Distance and direction from nearest town or city: 4 1/2 miles NE of Winfield
Street address of well location if in city:

3. Owner of well: George Story
R.R. or street: 7905 Jamicia
City, state, zip code: El Dorado, Kansas 67042

4. Locate with "X" in section below:

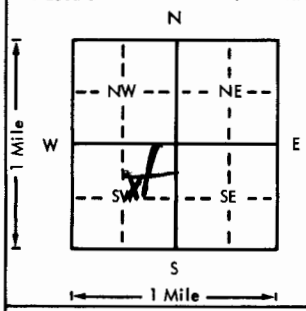

Sketch map:

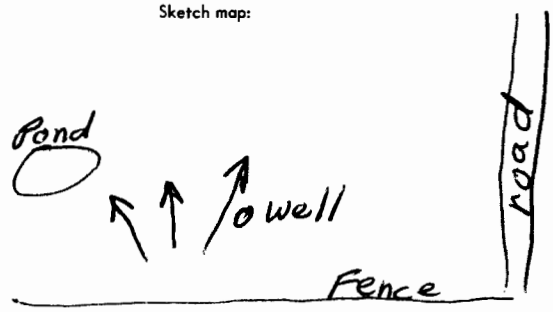

6. Bore hole dia. 15 in. Completion date 6-5-77
Well depth 10 ft.

7. X Cable tool __ Rotary __ Driven __ Dug
__ Hollow rod __ Jetted __ Bored __ Reverse rotary

8. Use: X Domestic __ Public supply __ Industry
X Irrigation __ Air conditioning __ Stock
__ Lawn __ Oil field water __ Other

9. Casing: Material RMP Height: Above or below
Threaded ___ Welded ___ Surface 14 in.
RMP X PVC ___ Weight 155 lbs./ft. 100
Dia. 6 in. to 75 ft. depth Wall Thickness: inches or
Dia. ___ in. to ___ ft. depth gage No. .250

10. Screw: Manufacturer's name Sunflower
Type RMP Dia. 6
Slot/gauze 110 Length 30 10'
Set between 65 ft. and 75 ft.
___ ft. and ___ ft.
Gravel pack? Yes X Size range of material 5/8"

11. Static water level: mo./day/yr.
30 ft. below land surface Date 6-5-75

12. Pumping level below land surfaces:
N.A. ft. after ___ hrs. pumping ___ g.p.m.
___ ft. after ___ hrs. pumping ___ g.p.m.
Estimated maximum yield 5 g.p.m.

13. Water sample submitted: mo./day/yr.
___ Yes X No Date

14. Well head completion:
X Pitless adapter ___ Inches above grade

15. Well grouted? Yes
With: ___ Neat cement ___ Bentonite X Concrete
Depth: From 0 ft. to 11 ft.

16. Nearest source of possible contamination:
ft. 150 Direction North Type Drainage
Well disinfected upon completion? X Yes ___ No

17. Pump: ___ Not installed
Manufacturer's name Myers
Model number 52652 HP 1/2 Volts 220
Length of drop pipe 70 ft. capacity 5 g.p.m.
Type:
X Submersible ___ Turbine
___ Jet ___ Reciprocating
___ Centrifugal ___ Other

5. Type and color of material

	From	To
Top Soil & Red Clay	0	11
Limestone	11	12
Red Clay	12	15
Limestone	15	47
Blue schale	47	55
Brown clay	55	63
Green clay	63	75

(Use o second sheet if needed)

18. Elevation:
Topography:
___ Hill
X Slope
X Upland
___ Valley

19. Remarks: House & buildings to be built later.

20. Water well contractor's certification:
This well was drilled under my jurisdiction and this report is true to the best of my knowledge and belief.
Business name EASTMAN Drilling License No. 299
Address Box 115, Winfield
Signed Dale Eastman Date 6-20-
Authorized representative

T 32 R 3 (E) W Sec 12 SW NE SW 1/4 1/4 1/4

Forward the white, blue and pink copies to the Department of Health and Environment

Form WWC-5

MI-1023