


1 LOCATION OF WATER WELL: County: ~~Goody~~ **Goody** Fraction: **SE 1/4 NW 1/4 SW 1/4** Section Number: **23** Township Number: **T 32 S** Range Number: **R 30 E**

Distance and direction from nearest town or city street address of well if located within city? **2 Mile W of Windfield Kan 1/2 N**

2 WATER WELL OWNER: **Oiane Quales**  
 RR#, St. Address, Box #: **PO Box 413 Rose Hill Kan 67133**  
 City, State, ZIP Code: **PO Box 413 Rose Hill Kan 67133**  
 Board of Agriculture, Division of Water Resources Application Number:

3 LOCATE WELL'S LOCATION WITH AN "X" IN SECTION BOX:

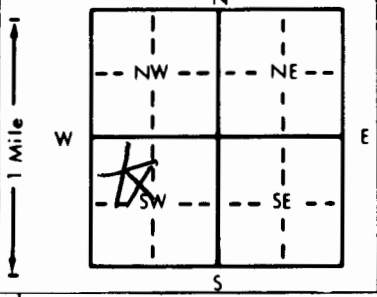

4 DEPTH OF COMPLETED WELL: **12.5** ft. ELEVATION: \_\_\_\_\_  
 Depth(s) Groundwater Encountered: **1. 8.5** ft. 2. \_\_\_\_\_ ft. 3. \_\_\_\_\_ ft.  
 WELL'S STATIC WATER LEVEL: **40** ft. below land surface measured on mo/day/yr  
 Pump test data: Well water was \_\_\_\_\_ ft. after \_\_\_\_\_ hours pumping \_\_\_\_\_ gpm  
 Est. Yield: **20** gpm. Well water was \_\_\_\_\_ ft. after \_\_\_\_\_ hours pumping \_\_\_\_\_ gpm  
 Bore Hole Diameter: **9 1/2** in. to \_\_\_\_\_ ft., and \_\_\_\_\_ in. to \_\_\_\_\_ ft.  
 WELL WATER TO BE USED AS:  
 1 Domestic     2 Irrigation     3 Feedlot     4 Industrial  
 5 Public water supply     6 Oil field water supply     7 Lawn and garden only  
 8 Air conditioning     9 Dewatering     10 Monitoring well  
 11 Injection well     12 Other (Specify below) \_\_\_\_\_  
 Was a chemical/bacteriological sample submitted to Department? Yes \_\_\_\_\_ No  If yes, mo/day/yr sample was submitted \_\_\_\_\_  
 Water Well Disinfected? Yes  No \_\_\_\_\_

5 TYPE OF BLANK CASING USED:  
 1 Steel     2 PVC     3 RMP (SR)     4 ABS     5 Wrought iron     6 Asbestos-Cement     7 Fiberglass     8 Concrete tile     9 Other (specify below)  
 Blank casing diameter: **5** in. to **4.5** ft., Dia \_\_\_\_\_ in. to \_\_\_\_\_ ft., Dia \_\_\_\_\_ in. to \_\_\_\_\_ ft.  
 Casing height above land surface: **18** in., weight **160** lbs./ft. Wall thickness or gauge No. **214**

TYPE OF SCREEN OR PERFORATION MATERIAL:  
 1 Steel     2 Brass     3 Stainless steel     4 Galvanized steel     5 Fiberglass     6 Concrete tile     7 PVC     8 RMP (SR)     9 ABS     10 Asbestos-cement     11 Other (specify) \_\_\_\_\_     12 None used (open hole)

SCREEN OR PERFORATION OPENINGS ARE:  
 1 Continuous slot     2 Louvered shutter     3 Mill slot     4 Key punched     5 Gauzed wrapped     6 Wire wrapped     7 Saw cut     8 Drilled holes     9 None (open hole)  
 10 Other (specify) \_\_\_\_\_

SCREEN-PERFORATED INTERVALS: From **45** ft. to **125** ft. From \_\_\_\_\_ ft. to \_\_\_\_\_ ft. From \_\_\_\_\_ ft. to \_\_\_\_\_ ft.  
 GRAVEL PACK INTERVALS: From \_\_\_\_\_ ft. to \_\_\_\_\_ ft. From \_\_\_\_\_ ft. to \_\_\_\_\_ ft. From \_\_\_\_\_ ft. to \_\_\_\_\_ ft.

6 GROUT MATERIAL:  1 Neat cement     2 Cement grout     3 Bentonite     4 Other \_\_\_\_\_  
 Grout Intervals: From **3** ft. to **23** ft. From \_\_\_\_\_ ft. to \_\_\_\_\_ ft. From \_\_\_\_\_ ft. to \_\_\_\_\_ ft.

What is the nearest source of possible contamination:  
 1 Septic tank     2 Sewer lines     3 Watertight sewer lines     4 Lateral lines     5 Cess pool     6 Seepage pit     7 Pit privy     8 Sewage lagoon     9 Feedyard     10 Livestock pens     11 Fuel storage     12 Fertilizer storage     13 Insecticide storage     14 Abandoned water well     15 Oil well/Gas well     16 Other (specify below) \_\_\_\_\_  
 Direction from well? **E** How many feet? **200**

FROM	TO	LITHOLOGIC LOG	FROM	TO	PLUGGING INTERVALS
0	4	Soil			
4	10	Clay			
10	18	Rock			
18	30	Clay			
30	125	Shale + Lime			

7 CONTRACTOR'S OR LANDOWNER'S CERTIFICATION: This water well was  constructed, (2) reconstructed, or (3) plugged under my jurisdiction and was completed on (mo/day/year) **2/3/94** and this record is true to the best of my knowledge and belief. Kansas Water Well Contractor's License No. **1254** This Water Well Record was completed on (mo/day/yr) **2/23/94** under the business name of **Water Well Drills** by signature **Charles Winter**