USE TYPEWRITER OR BALL POINT PEN-PRESS FIRMLY, PRINT CLEARLY.

T R EW sec 1/4 1/4 1/4 No.

WATER WELL RECORD
KSA 82a-1201-1215

Kansas State Dept. Of Health
(Water Well Contractors)
Forbes-Bldg. 740
Topeka, Kansas 66620

1 Location of well:	County	Township name	Fraction	Section number	Town number	Range number
	Cowley	Winfield	SE 1/4 SE 1/4 SE 1/4	24	32	3 E

Distance and direction from nearest town or city: 2 mi west of Winfield, Ks.

Street address of well location if in city:

3 Owner of well: Mike Delano

Address: RR #2 Winfield, Ks. 67156

Locate with "X" in section below:

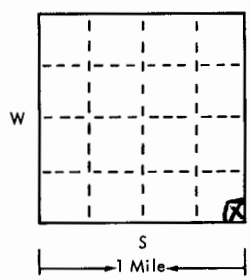

Sketch map:

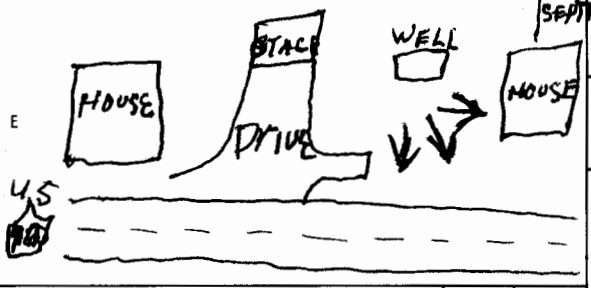

4 Well depth: 100 ft. Date of completion 7/25/76
Well diameter 10 in.

5 [X] Cable tool [ ] Rotary [ ] Driven [ ] Dug [ ] Hollow rod [ ] Jetted [ ] Bored [ ] Reverse rotary

6 Use: [X] Domestic [ ] Public supply [ ] Industry [ ] Irrigation [ ] Air conditioning [ ] Commercial [ ] Test well [ ]

7 Casing: Material RMP Height: above/below
Threaded [ ] Welded [ ] Surface 16 in.
Diam. 6 in. to ___ ft. depth Weight ___ lbs./ft.
___ in. to ___ ft. depth Drive shoe? [ ] Yes [X] No

2 Type and color of material	From	To
TOP SOIL	0	2
SANDY RED CLAY	2	52
FINE SAND & WATER & CLAY (QUICK SAND)	32	55
BLUE SCHALE	55	65
Soft GRAY SCHALE	65	85
HARD GRAY Schale	85	100
(use o second sheet if needed)		

8 Screen:
Manufacturer SUNFLOWER
Type RMP Dia. 6"
Slot/gauze 18 Length 30"
Set between 70 ft. and 100 ft.
Fittings:
Gravel pack [X] Yes [ ] No Size range of material 3/8

9 Static water level: 43 ft. below land surface Date 7/20/76

10 Pumping level below land surfaces: 65 ft. after ___ hrs. pumping ___ g.p.m.
___ ft. after ___ hrs. pumping ___ g.p.m.
Estimated maximum yield ___ g.p.m.

11 Water sample submitted: [X] Yes [ ] No Date ___

12 Well head completion: [X] Pitless adapter [ ] Inches above grade

13 Well grouted? [X] Yes [ ] No
[ ] Neat cement [ ] Bentonite [ ] ___
Depth: From 0 ft. to 14 ft.

14 Nearest source of possible contamination:
ft. 70 Direction EAST Type SEPTIC
Well disinfected upon completion? [X] Yes [ ] No

15 Pump: [X] Not installed
Manufacturer's name MYERS
Model number S2G51 HP 1/2 Volts 230
Length of drop pipe 93 ft. capacity 6 g.m.p.
Type:
[X] Submersible [ ] Turbine
[ ] Jet [ ] Reciprocating
[ ] Certrifugal [ ] Other

16 Remarks: elevation

Topography:
[ ] Hill
[X] Slope
[X] Upland
[ ] Valley

17 Water well contractor's certification:
This well was drilled under my jurisdiction and this report is true to the best of my knowledge and belief.
EASTMAN Drilling 299
Business name License No.
Address 221 Millington
Signed [illegible] Eastman Date 7/30/76
Authorized representative

32 3E 24 SESE

Forward the white, blue and pink copies to the Kansas State Dept. Of Health.

Form WWC-5

677-H