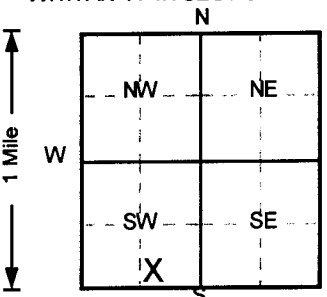


1 LOCATION OF WATER WELL: Fraction Section Number Township Number Range Number  
 County: **Cowley** SW ¼ SE ¼ SW ¼ 21 T 32 S R 4 **EW**

Distance and direction from nearest town or city street address of well if located within city?  
**200' N. of 5th and East side of Menor**

2 WATER WELL OWNER: **Winfield Farmers Union Coop**  
 RR#, St. Address, Box # : **P.O. Box 536** Board of Agriculture, Division of Water Resources  
 City, State, ZIP Code : **Winfield, Kansas 67156** Application Number:

3 LOCATE WELL'S LOCATION WITH AN "X" IN SECTION BOX:  

 4 DEPTH OF COMPLETED WELL **18** ft ELEVATION: **1122.19**  
 Depth(s) Groundwater Encountered 1. **16** ft 2. \_\_\_\_\_ ft 3. \_\_\_\_\_ ft  
 WELL'S STATIC WATER LEVEL **12.17** ft below land surface measured on mo/day/yr **9/22/95**  
 Pump test data: Well water was **NA** ft after \_\_\_\_\_ hours pumping \_\_\_\_\_ gpm  
 Est Yield **NA** gpm: Well water was \_\_\_\_\_ ft after \_\_\_\_\_ hours pumping \_\_\_\_\_ gpm  
 Bore Hole Diameter **8** in. to **18** ft, and \_\_\_\_\_ in. to \_\_\_\_\_ ft  
 WELL WATER TO BE USED AS:  
 5 Public water supply 8 Air conditioning 11 Injection well  
 1 Domestic 3 Feedlot 6 Oil field water supply 9 Dewatering 12 Other (Specify below)  
 2 Irrigation 4 Industrial 7 Lawn and garden only **10** Monitoring well  
 Was a chemical/bacteriological sample submitted to Department? Yes.....No ; If yes, mo/day/yr sample was submitted  
 Water Well Disinfected? Yes \_\_\_\_\_ No

5 TYPE OF BLANK CASING USED:  
 1 Steel 3 RMP (SR) 5 Wrought iron 8 Concrete tile CASING JOINTS: Glued \_\_\_\_\_ Clamped \_\_\_\_\_  
**2** PVC 4 ABS 6 Asbestos-Cement 9 Other (specify below) Welded \_\_\_\_\_  
 7 Fiberglass \_\_\_\_\_ Threaded   
 Blank casing diameter **2** in. to **8** ft, Dia \_\_\_\_\_ in. to \_\_\_\_\_ ft, Dia \_\_\_\_\_ in. to \_\_\_\_\_ ft  
 Casing height above land surface **7.56** in., weight \_\_\_\_\_ lbs./ft. Wall thickness or gauge No. **Sch. 40**  
 TYPE OF SCREEN OR PERFORATION MATERIAL  
 1 Steel 3 Stainless steel 5 Fiberglass **7** PVC 10 Asbestos-cement  
 2 Brass 4 Galvanized steel 6 Concrete tile 8 RMP (SR) 11 Other (specify) \_\_\_\_\_  
 12 None used (open hole)  
 SCREEN OR PERFORATION OPENINGS ARE:  
 1 Continuous slot **3** Mill slot 5 Gauzed wrapped 8 Saw cut 11 None (open hole)  
 2 Louvered shutter 4 Key punched 6 Wire wrapped 9 Drilled holes  
 7 Torch cut 10 Other (specify) \_\_\_\_\_  
 SCREEN-PERFORATED INTERVALS: From **8** ft to **18** ft, From \_\_\_\_\_ ft to \_\_\_\_\_ ft  
 From \_\_\_\_\_ ft to \_\_\_\_\_ ft, From \_\_\_\_\_ ft to \_\_\_\_\_ ft  
 GRAVEL PACK INTERVALS: From **7** ft to **18** ft, From \_\_\_\_\_ ft to \_\_\_\_\_ ft  
 From \_\_\_\_\_ ft to \_\_\_\_\_ ft, From \_\_\_\_\_ ft to \_\_\_\_\_ ft

6 GROUT MATERIAL: 1 Neat cement **2** Cement grout **3** Bentonite 4 Other \_\_\_\_\_  
 Grout Intervals: From **0** ft to **4** ft, From **4** ft to **7** ft, From \_\_\_\_\_ ft to \_\_\_\_\_ ft  
 What is the nearest source of possible contamination:  
 1 Septic tank 4 Lateral lines 7 Pit privy 10 Livestock pens 14 Abandoned water well  
 2 Sewer lines 5 Cess pool 8 Sewage lagoon 11 Fuel storage 15 Oil well/Gas well  
 3 Watertight sewer lines 6 Seepage pit 9 Feedyard 12 Fertilizer storage **16** Other (specify below)  
 13 Insecticide storage \_\_\_\_\_ UST Basin \_\_\_\_\_  
 Direction from well? **SE** How many feet? **210**

FROM	TO	LITHOLOGIC LOG	FROM	TO	PLUGGING INTERVALS
0	2	Sand,			
2	5	Clay, Dark Brown			
5	12	Clay, Red Brown			
12	16	Clay, Red Brown			
16	18	Clay, Light Red Brown			
					MW3, Tag # 131355, Flushmount
					Project Name: Winfield Coop - Iron
					GeoCore # 145, U2 018 1355 #

7 CONTRACTOR'S OR LANDOWNER'S CERTIFICATION: This water well was **1** constructed, (2) reconstructed, or (3) plugged under my jurisdiction and was completed on (mo/day/year) **9/20/95** and this record is true to the best of my knowledge and belief.  
 Kansas Water Well Contractor's License No. **527** This Water Well Record was completed on (mo/day/yr) **10/16/95**  
 under the business name of **GeoCore Services, Inc.** by (signature) *Paul Robb*