


1 LOCATION OF WATER WELL: County: Cowley Fraction SE 1/4 NE 1/4 SW 1/4 Section Number 32 Township Number T 32S S Range Number R 4E EW

Distance and direction from nearest town or city street address of well if located within city? 2912 Cabrillo Winfield, Kansas 67156

2 WATER WELL OWNER: Gary Foust RR#, St. Address, Box #: 2912 Cabrillo City, State, ZIP Code: Winfield, Kansas 67156 Board of Agriculture, Division of Water Resources Application Number:

3 LOCATE WELL'S LOCATION WITH AN "X" IN SECTION BOX: 4 DEPTH OF COMPLETED WELL: 100 ft. ELEVATION:

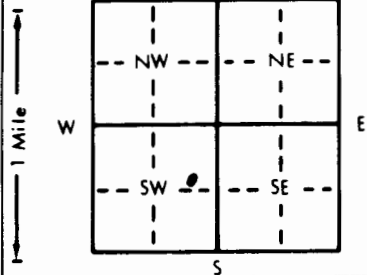

Depth(s) Groundwater Encountered... WELL'S STATIC WATER LEVEL... 15 ft. below land surface measured on mo/day/yr 5/2/97 Pump test data: Well water was... Est. Yield... Bore Hole Diameter... 9 in. WELL WATER TO BE USED AS: 7 Lawn and garden only... Was a chemical/bacteriological sample submitted to Department? Yes... No... X... Water Well Disinfected? Yes X No

5 TYPE OF BLANK CASING USED: 2 PVC 5 Wrought iron 8 Concrete tile CASING JOINTS: Glued X Clamped Welded Threaded Blank casing diameter... 5 in. to 40 ft., Dia... Casing height above land surface... 24 in., weight... lbs./ft. Wall thickness or gauge No. SDR26

TYPE OF SCREEN OR PERFORATION MATERIAL: 7 PVC 10 Asbestos-cement 11 Other (specify) 12 None used (open hole)

SCREEN OR PERFORATION OPENINGS ARE: 8 RMP (SR) 11 Other (specify) 12 None used (open hole) 8 Saw cut 11 None (open hole) 9 Drilled holes 10 Other (specify)

SCREEN-PERFORATED INTERVALS: From 40 ft. to 100 ft. GRAVEL PACK INTERVALS: From 20 ft. to 100 ft.

6 GROUT MATERIAL: 3 Bentonite 4 Other Grout Intervals: From 4 ft. to 20 ft. What is the nearest source of possible contamination: 1 Septic tank 4 Lateral lines 7 Pit privy 11 Fuel storage 15 Oil well/Gas well 2 Sewer lines 5 Cess pool 8 Sewage lagoon 12 Fertilizer storage 16 Other (specify below) 3 Watertight sewer lines 6 Seepage pit 9 Feedyard 13 Insecticide storage

Direction from well? How many feet? Table with columns: FROM, TO, LITHOLOGIC LOG, FROM, TO, PLUGGING INTERVALS. Rows: 0-10 Soil, 10-55 Lime, 55-68 Shale (blue), 68-80 Shale (purple), 80-95 Shale (brown), 95-100 Lime

7 CONTRACTOR'S OR LANDOWNER'S CERTIFICATION: This water well was (1) constructed, (2) reconstructed, or (3) plugged under my jurisdiction and was completed on (mo/day/year) 5/2/97 and this record is true to the best of my knowledge and belief. Kansas Water Well Contractor's License No. 171 This Water Well Record was completed on (mo/day/yr) 5/2/97 under the business name of G & S Drilling, Inc. by (signature) Timothy E. Brandt

OFFICE USE ONLY T R E W SEC. 1/4 1/4 1/4