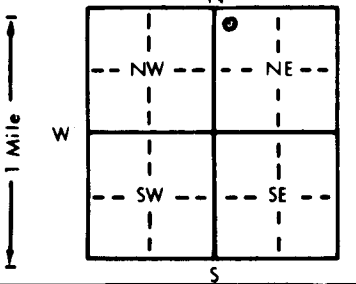


1 LOCATION OF WATER WELL: County: **Cowley** Fraction: **NW 1/4 NW 1/4 NE 1/4** Section Number: **26** Township Number: **T 32 S** Range Number: **R 4 E**

Distance and direction from nearest town or city street address of well if located within city?  
**Highway 160 East**

2 WATER WELL OWNER: **Winfield Operations Center**  
 RR#, St. Address, Box #: **Highway 160 East**  
 City, State, ZIP Code: **Winfield Kansas**  
 Board of Agriculture, Division of Water Resources  
 Application Number:

3 LOCATE WELL'S LOCATION WITH AN "X" IN SECTION BOX:  4 DEPTH OF COMPLETED WELL: **12'** ft. ELEVATION:  
 Depth(s) Groundwater Encountered 1. **10'** ft. 2. ft. 3. ft.  
 WELL'S STATIC WATER LEVEL: **10.87'** ft. below land surface measured on mo/day/yr **10-1-98**  
 Pump test data: Well water was ft. after hours pumping gpm  
 Est. Yield gpm; Well water was ft. after hours pumping gpm  
 Bore Hole Diameter: **8 1/2"** in. to **12'** ft. and in. to ft.  
 WELL WATER TO BE USED AS:  
 1 Domestic 2 Irrigation 3 Feedlot 4 Industrial 5 Public water supply 6 Oil field water supply 7 Lawn and garden only 8 Air conditioning 9 Dewatering 10 Monitoring well 11 Injection well 12 Other (Specify below)  
 Was a chemical/bacteriological sample submitted to Department? Yes No; If yes, mo/day/yr sample was sub-  
 mitted Water Well Disinfected? Yes **No**

5 TYPE OF BLANK CASING USED:  
 1 Steel 2 **PVC** 3 RMP (SR) 4 **ABS** 5 Wrought iron 6 Asbestos-Cement 7 Fiberglass 8 Concrete tile 9 Other (specify below) CASING JOINTS: Glued Clamped Welded Threaded **X**  
 Blank casing diameter: **2.375** in. to **5'** ft., Dia. in. to in. to in. to in. to ft.  
 Casing height above land surface: **Flush Mt.** in., weight lbs./ft. Wall thickness or gauge No. **SDR-13**  
 TYPE OF SCREEN OR PERFORATION MATERIAL: **7 PVC** 10 Asbestos-cement **sch 40**  
 1 Steel 2 Brass 3 Stainless steel 4 Galvanized steel 5 Fiberglass 6 Concrete tile 8 RMP (SR) 9 ABS 11 Other (specify) 12 None used (open hole)  
 SCREEN OR PERFORATION OPENINGS ARE:  
 1 Continuous slot 2 Louvered shutter 3 **Mill slot** 4 Key punched 5 Gauzed wrapped 6 Wire wrapped 7 Torch cut 8 Saw cut 9 Drilled holes 11 None (open hole) 10 Other (specify)  
 SCREEN-PERFORATED INTERVALS: From **12'** ft. to **5'** ft., From ft. to ft. ft. to ft. ft. to ft.  
 GRAVEL PACK INTERVALS: From **12'** ft. to **4'** ft., From ft. to ft. ft. to ft. ft. to ft.

6 GROUT MATERIAL: 1 Neat cement 2 **Cement grout** 3 **Bentonite** 4 Other  
 Grout Intervals: From **4'** ft. to **3'** ft., From **3'** ft. to **0'** ft., From ft. to ft. ft. to ft.  
 What is the nearest source of possible contamination:  
 1 Septic tank 2 Sewer lines 3 Watertight sewer lines 4 Lateral lines 5 Cess pool 6 Seepage pit 7 Pit privy 8 Sewage lagoon 9 Feedyard 10 Livestock pens 11 **Fuel storage FOMEL** 12 Fertilizer storage 13 Insecticide storage 14 Abandoned water well 15 Oil well/Gas well 16 Other (specify below)  
 Direction from well? **In cul. PD** How many feet? **0-**

FROM	TO	LITHOLOGIC LOG	FROM	TO	PLUGGING INTERVALS
0	1	concrete			
1	8.5	Silty clay, red brown, moist, firm, black mottled, sl odor			
8.5	11	Silty clay, pale-light brown, sand, green, oxide stained			
11	12	Limestone-bedrock B.O.H. 12'			
					Fl.mt. OK'D by Don Taylor

7 CONTRACTOR'S OR LANDOWNER'S CERTIFICATION: This water well was (1) **constructed** (2) reconstructed, or (3) plugged under my jurisdiction and was completed on (mo/day/year) **9-9-98** and this record is true to the best of my knowledge and belief. Kansas Water Well Contractor's License No. **539** This Water Well Record was completed on (mo/day/yr) **11-6-98** under the business name of **JB Environmental Drilling** by (signature) **James Becker**

OFFICE USE ONLY  
T  
R  
EW  
SEC  
1/4  
1/4  
1/4