


1 LOCATION OF WATER WELL: County: Cowley Fraction: NW 1/4 NW 1/4 NE 1/4 Section Number: 26 Township Number: T 32 S Range Number: R 4 E

Distance and direction from nearest town or city street address of well if located within city?
Highway 160 East

2 WATER WELL OWNER: Winfield Operations Center
 RR#, St. Address, Box #: Highway 160 East
 City, State, ZIP Code: Winfield Kansas
 Board of Agriculture, Division of Water Resources
 Application Number:

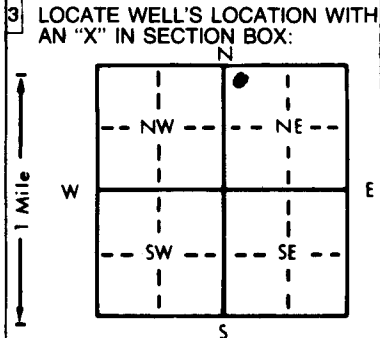

4 DEPTH OF COMPLETED WELL: 11 1/2' ft. ELEVATION: ft.
 Depth(s) Groundwater Encountered: 1. ft. 2. ft. 3. ft.
 WELL'S STATIC WATER LEVEL: 9.36 ft. below land surface measured on mo/day/yr 10-1-98
 Pump test data: Well water was ft. after hours pumping gpm
 Est. Yield gpm; Well water was ft. after hours pumping gpm
 Bore Hole Diameter: 8 1/2" in. to 11 1/2" ft., and in. to ft.
 WELL WATER TO BE USED AS:
 1 Domestic 3 Feedlot 6 Oil field water supply 9 Dewatering 12 Other (Specify below)
 2 Irrigation 4 Industrial 7 Lawn and garden only 10 Monitoring well
 Was a chemical/bacteriological sample submitted to Department? Yes No X If yes, mo/day/yr sample was submitted
 Water Well Disinfected? Yes No NO

5 TYPE OF BLANK CASING USED:
 1 Steel 3 RMP (SR) 5 Wrought iron 8 Concrete tile CASING JOINTS: Glued Clamped
2 PVC 4 ABS 6 Asbestos-Cement 9 Other (specify below) Welded
 7 Fiberglass Threaded X
 Blank casing diameter: 2.375 in. to 4 1/2' ft., Dia in. to ft., Dia in. to ft.
 Casing height above land surface: Flush 14' in., weight lbs./ft. Wall thickness or gauge No. 30E-13
 TYPE OF SCREEN OR PERFORATION MATERIAL:
 1 Steel 3 Stainless steel 5 Fiberglass 7 PVC 10 Asbestos-cement sch 40
 2 Brass 4 Galvanized steel 6 Concrete tile 9 ABS 12 None used (open hole)
 SCREEN OR PERFORATION OPENINGS ARE:
 1 Continuous slot 3 Mill slot 5 Gauzed wrapped 8 Saw cut 11 None (open hole)
 2 Louvered shutter 4 Key punched 6 Wire wrapped 9 Drilled holes
 3 Torched cut 10 Other (specify)
 SCREEN-PERFORATED INTERVALS: From 11 1/2' ft. to 4 1/2' ft., From ft. to ft.
 From ft. to ft., From ft. to ft.
 GRAVEL PACK INTERVALS: From 11 1/2' ft. to 3' ft., From ft. to ft.
 From ft. to ft., From ft. to ft.

6 GROUT MATERIAL: 1 Neat cement 2 Cement grout 3 Bentonite 4 Other
 Grout Intervals: From 3' ft. to 2' ft., From 2' ft. to 0' ft., From ft. to ft.
 What is the nearest source of possible contamination:
 1 Septic tank 4 Lateral lines 7 Pit privy 2 10 Livestock pens 14 Abandoned water well
 2 Sewer lines 5 Cess pool 8 Sewage lagoon 11 Fuel storage Foumel 15 Oil well/Gas well
 3 Watertight sewer lines 6 Seepage pit 9 Feedyard 12 Fertilizer storage 16 Other (specify below)
 13 Insecticide storage
 Direction from well? Northeast How many feet? 90'

FROM	TO	LITHOLOGIC LOG	FROM	TO	PLUGGING INTERVALS
0	1	Asphalt			
1	5	Silty clay, dark red/brown, moist, black mottled, sl odor			
5	10.5	Silty clay, pale brown, very moist, trace sand, firm, black mottled in part, sl odor			
10.5	11.5	Limestone-bedrock B.O.H. 11.5'			
					Fl. mt. OK'D by Don Taylor

7 CONTRACTOR'S OR LANDOWNER'S CERTIFICATION: This water well was constructed (1) constructed, (2) reconstructed, or (3) plugged under my jurisdiction and was completed on (mo/day/year) 4-10-98 and this record is true to the best of my knowledge and belief. Kansas Water Well Contractor's License No. 539 This Water Well Record was completed on (mo/day/yr) 11-6-98 under the business name of JB Environmental Drilling by (signature) James Bieber

OFFICE USE ONLY

T

R

EW

SEC

1/4

1/4

1/4