


1 LOCATION OF WATER WELL: Fraction NW 1/4 NW 1/4 NE 1/4 Section Number 26 Township Number T 32 S Range Number R 4 **(BW)**
 County: Cowley

Distance and direction from nearest town or city street address of well if located within city?
Highway 160 East

2 WATER WELL OWNER: Winfield Operations Center
 RR#, St. Address, Box #: Highway 160 East Board of Agriculture, Division of Water Resources
 City, State, ZIP Code: Winfield Kansas Application Number:

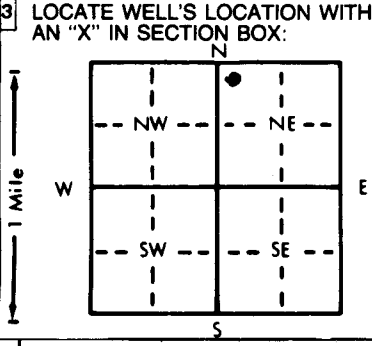

4 DEPTH OF COMPLETED WELL: 13' ft. ELEVATION:
 Depth(s) Groundwater Encountered 11' ft. 2. ft. 3. ft.
 WELL'S STATIC WATER LEVEL: 11.43 ft. below land surface measured on mo/day/yr 10-1-98
 Pump test data: Well water was _____ ft. after _____ hours pumping _____ gpm
 Est. Yield _____ gpm Well water was _____ ft. after _____ hours pumping _____ gpm
 Bore Hole Diameter: 8 1/2" in. to 13' ft. and _____ in. to _____ ft.
 WELL WATER TO BE USED AS:
 5 Public water supply 8 Air conditioning 11 Injection well
 1 Domestic 3 Feedlot 6 Oil field water supply 9 Dewatering 12 Other (Specify below)
 2 Irrigation 4 Industrial 7 Lawn and garden only 10 Monitoring well
 Was a chemical/bacteriological sample submitted to Department? Yes _____ No X If yes, mo/day/yr sample was submitted _____
 Water Well Disinfected? Yes _____ No (No)

5 TYPE OF BLANK CASING USED:
 1 Steel 3 RMP (SR) 5 Wrought iron 8 Concrete tile CASING JOINTS: Glued _____ Clamped _____
2 PVC 4 ABS 6 Asbestos-Cement 9 Other (specify below) Welded _____
 7 Fiberglass Threaded X
 Blank casing diameter 2.375 in. to 5' ft. Dia _____ in. to _____ ft. Dia _____ in. to _____ ft.
 Casing height above land surface Flush Mt. in., weight _____ lbs./ft. Wall thickness or gauge No. SOR-B Sch 40
 TYPE OF SCREEN OR PERFORATION MATERIAL:
 1 Steel 3 Stainless steel 5 Fiberglass 8 RMP (SR) 11 Other (specify) _____
 2 Brass 4 Galvanized steel 6 Concrete tile 9 ABS 12 None used (open hole)
 SCREEN OR PERFORATION OPENINGS ARE:
 1 Continuous slot 3 Mill slot 5 Gauzed wrapped 8 Saw cut 11 None (open hole)
 2 Louvered shutter 4 Key punched 6 Wire wrapped 9 Drilled holes
 7 Torch cut 10 Other (specify) _____
 SCREEN-PERFORATED INTERVALS: From 13' ft. to 5' ft. From _____ ft. to _____ ft.
 GRAVEL PACK INTERVALS: From 13' ft. to 4 1/2' ft. From _____ ft. to _____ ft.
 From _____ ft. to _____ ft. From _____ ft. to _____ ft.

6 GROUT MATERIAL: 1 Neat cement 2 Cement grout 3 Bentonite 4 Other _____
 Grout Intervals: From 4 1/2' to 3' ft. From 3' to 0' ft. From _____ ft. to _____ ft.
 What is the nearest source of possible contamination:
 1 Septic tank 4 Lateral lines 7 Pit privy 10 Livestock pens 14 Abandoned water well
 2 Sewer lines 5 Cess pool 8 Sewage lagoon 11 Fuel storage Funnel 15 Oil well/Gas well
 3 Watertight sewer lines 6 Seepage pit 9 Feedyard 12 Fertilizer storage 16 Other (specify below) _____
 13 Insecticide storage
 Direction from well? North How many feet? 80'

FROM	TO	LITHOLOGIC LOG	FROM	TO	PLUGGING INTERVALS
0	.5	Asphalt			
.5	2	Silty Clay, brown, dry-moist, very firm, sl odor			
2	9	Silty clay, red/brown, moist, firm, black mottled, sl odor			
9	11.5	Silty clay, brown, moist, oxides, sl odor			
11.5	13	Limestone- bedrock			
		B.O.H. 13'			
					Fl. mt. OK'D by Don Taylor

7 CONTRACTOR'S OR LANDOWNER'S CERTIFICATION: This water well was (1) constructed, (2) reconstructed, or (3) plugged under my jurisdiction and was completed on (mo/day/year) 9-10-98 and this record is true to the best of my knowledge and belief. Kansas Water Well Contractor's License No. 539 This Water Well Record was completed on (mo/day/yr) 11-6-98 under the business name of JB Environmental Drilling by (signature) James Beebe

OFFICE USE ONLY
T
R
EW
SEC.
1/4
1/4
1/4