


1 LOCATION OF WATER WELL: Fraction NW 1/4 NW 1/4 NE 1/4 Section Number 26 Township Number T 32 S Range Number R 4 **EW**
 County: Cowley

Distance and direction from nearest town or city street address of well if located within city?
Highway 160 East

2 WATER WELL OWNER: Winfield Operations Center
 RR#, St. Address, Box #: Highway 160 East Board of Agriculture, Division of Water Resources
 City, State, ZIP Code: Winfield Kansas Application Number:

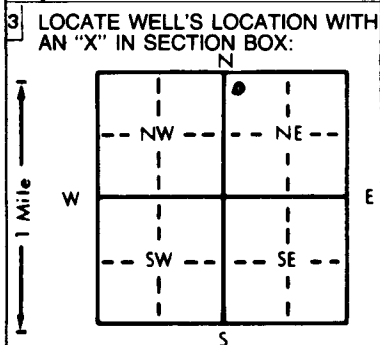

4 DEPTH OF COMPLETED WELL: 12 1/2' ft. ELEVATION: ft.
 Depth(s) Groundwater Encountered 1. 12 ft. 2. ft. 3. ft.
 WELL'S STATIC WATER LEVEL 10.08 ft. below land surface measured on mo/day/yr 10-1-98
 Pump test data: Well water was ft. after hours pumping gpm
 Est. Yield gpm; Well water was ft. after hours pumping gpm
 Bore Hole Diameter: 8 1/2" in. to 12 1/2" in. to ft., and in. to ft.
 WELL WATER TO BE USED AS:
 5 Public water supply 8 Air conditioning 11 Injection well
 1 Domestic 3 Feedlot 6 Oil field water supply 9 Dewatering 12 Other (Specify below)
 2 Irrigation 4 Industrial 7 Lawn and garden only **10** Monitoring well
 Was a chemical/bacteriological sample submitted to Department? Yes.....No. **X**.....; If yes, mo/day/yr sample was submitted
 Water Well Disinfected? Yes **No**

5 TYPE OF BLANK CASING USED:
 1 Steel **2 PVC** 3 RMP (SR) 4 ABS 5 Wrought iron 6 Asbestos-Cement 7 Fiberglass 8 Concrete tile 9 Other (specify below) CASING JOINTS: Glued Clamped
 Blank casing diameter 2.375 in. to 4 in. Dia in. to ft., Dia in. to ft.
 Casing height above land surface FLUSH MT in., weight lbs./ft. Wall thickness or gauge No. SDR-13
 TYPE OF SCREEN OR PERFORATION MATERIAL: **7 PVC** 10 Asbestos-cement Sen 40 11 Other (specify)
 1 Steel 3 Stainless steel 5 Fiberglass 8 RMP (SR) 12 None used (open hole)
 2 Brass 4 Galvanized steel 6 Concrete tile 9 ABS
 SCREEN OR PERFORATION OPENINGS ARE:
 1 Continuous slot 2 Louvered shutter 3 Mill slot 4 Key punched 5 Gauzed wrapped 6 Wire wrapped 7 Torch cut 8 Saw cut 9 Drilled holes 11 None (open hole)
 SCREEN-PERFORATED INTERVALS: From 12 1/2' ft. to 4' ft., From ft. to ft.
 GRAVEL PACK INTERVALS: From 12 1/2' ft. to 3' ft., From ft. to ft.

6 GROUT MATERIAL: 1 Neat cement 2 Cement grout 3 Bentonite 4 Other
 Grout Intervals: From 3' ft. to 2' ft., From 2' ft. to 0' ft., From ft. to ft.
 What is the nearest source of possible contamination: **3** 10 Livestock pens 11 Fuel storage Fouled 14 Abandoned water well
 1 Septic tank 2 Sewer lines 3 Watertight sewer lines 4 Lateral lines 5 Cess pool 6 Seepage pit 7 Pit privy 8 Sewage lagoon 9 Feedyard 12 Fertilizer storage 13 Insecticide storage 15 Oil well/Gas well 16 Other (specify below)
 Direction from well? WIND How many feet? 65'

FROM	TO	LITHOLOGIC LOG	FROM	TO	PLUGGING INTERVALS
0	.5	Asphalt			
.5	7	Silty clay, red brown, moist, firm, trace gravel, sl odor			
7	11	Silty clay, brown, moist, firm black mottled, sl odor			
11	12.5	Limestone-bedrock			
					Fl. mt. OK'D by Don Taylor

7 CONTRACTOR'S OR LANDOWNER'S CERTIFICATION: This water well was (1) **constructed** (2) reconstructed, or (3) plugged under my jurisdiction and was completed on (mo/day/year) 9-10-98 and this record is true to the best of my knowledge and belief. Kansas Water Well Contractor's License No. 539 This Water Well Record was completed on (mo/day/yr) 11-6-98 under the business name of JB Environmental Drilling by (signature) James Beebe

OFFICE USE ONLY
T
R
EW
SEC.
1/4
1/4
1/4