


1	LOCATION OF WATER WELL:	Fraction SE 1/4 SW 1/4 SW 1/4	Section Number 03	Township Number 32	Range Number 04
County: <u>Cowley</u>					

Distance and direction from nearest town or city street address of well if located within city?
2 miles North of Winfield

2 WATER WELL OWNER: Jack Sowder
RR#, St. Address, Box #: PO Box 480
City, State, ZIP Code: Winfield, KS 67156

Board of Agriculture, Division of Water Resources
Application Number:

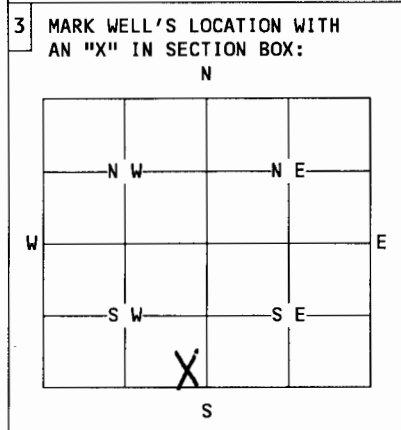

4 DEPTH OF WELL.....100'.....ft.
WELL'S STATIC WATER LEVEL.....40'.....ft.

WELL WAS USED AS:

<input checked="" type="checkbox"/> 1 Domestic	5 Public Water Supply	9 Dewatering
<input type="checkbox"/> 2 Irrigation	6 Oil Field Water Supply	10 Monitoring Well
<input type="checkbox"/> 3 Feedlot	7 Lawn and Garden Only	11 Injection Well
<input type="checkbox"/> 4 Industrial	8 Air Conditioning	12 Other.....

Was a chemical/bacteriological sample submitted to Department? Yes....No...
If yes, mo/day/yr sample was submitted.....

Water Well Disinfected: Yes...... No.....

5 TYPE OF BLANK CASING USED:

<input checked="" type="checkbox"/> 1 Steel	3 RMP (SR)	5 Wrought	7 Fiberglass	9 Other (specify below)
<input type="checkbox"/> 2 PVC	4 ABS	6 Asbestos-Cement	8 Concrete Tile	

Blank casing diameter.....8.....in. Was casing pulled? Yes...... No..... If yes, how much.....4'.....
Casing height above or below land surface.....N/A.....in.

6 GROUT PLUG MATERIAL: 1 Neat cement 2 Cement grout 3 Bentonite 4 Other.....

Grout Plug Intervals: From.....ft. to.....ft., From.....ft. to.....ft., From..... to.....ft.

What is the nearest source of possible contamination:

1 Septic tank	6 Seepage pit	11 Fuel storage	16 Other (specify below)
2 Sewer lines	7 Pit privy	12 Fertilizer storage	
3 Watertight sewer lines	8 Sewage lagoon	13 Insecticide storage	
4 Lateral lines	9 Feedyard	<input checked="" type="checkbox"/> 14 Abandoned water well	
5 Cess Pool	10 Livestock pens	15 Oil well/Gas well	

Direction from well?West..... How many feet?15'.....

FROM	TO	PLUGGING MATERIALS
0	3'	topsoil
3'	6'	bentonite plug
6'	100'	sand (washed)

RECEIVED
SEP 24 2004
BUREAU OF WATER

7 CONTRACTOR'S OR (LANDOWNER'S CERTIFICATION) This water well was plugged under my jurisdiction and was completed on (mo/day/year).....09/17/04..... and this record is true to the best of my knowledge and belief. Kansas Water Well Contractor's License No.N/A..... This Water Well Record was completed on (mo/day/year) under the business name of
by (signature) Jack Sowder

INSTRUCTIONS: Use typewriter or ball point pen. Please press firmly and print clearly. Please fill in blanks, underline or circle the correct answers. Send top three copies to Kansas Department of Health and Environment, Bureau of Water, Topeka, Kansas 66620-0001. Telephone: 913/296-3565. Send one to Water Well Owner and retain one for your records.