


1 LOCATION OF WATER WELL:	Fraction	Section Number	Township Number	Range Number
County: Cowley	SE 1/4 NE 1/4 NW 1/4	33	32 S	4E

Distance and direction from nearest town or city street address of well if located within city?
2126 S. Main, Winfield, Kansas

2 WATER WELL OWNER: Wal-Mart #369-01	Board of Agriculture, Division of Water Resources Application Number: _____
RR#, St. Address, Box # 2202 Pike Road	
City, State, ZIP Code : Winfield, KS 67156	

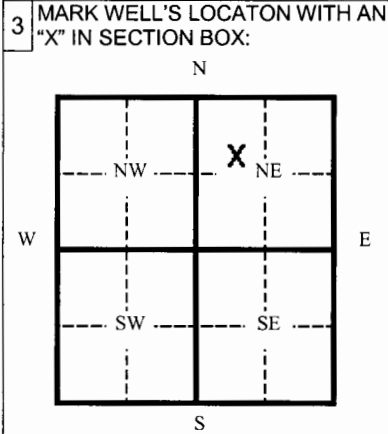

4	DEPTH OF WELL _____ 20.0 _____ ft.	
	WELL'S STATIC WATER LEVEL _____ None _____ ft.	
	WELL WAS USED AS:	
	1 Domestic	5 Public Water Supply
	2 Irrigation	6 Oil Field Water Supply
	3 Feedlot	7 Lawn and Garden (domestic)
	4 Industrial	8 Air Conditioning
		9 Dewatering
		10 <u>Monitoring Well</u>
		11 Injection Well
		12 Other _____

Was a chemical/bacteriological sample submitted to Department? Yes ___ No ___
 If yes, mo/day/yr sample was submitted _____
 Water Well Disinfected: Yes ___ No ___

5 TYPE OF BLANK CASING USED:

1 Steel	3 RMP (SR)	5 Wrought	7 Fiberglass	9 Other (specify below)
2 PVC	4 ABC	6 Asbestos-Cement	8 Concrete Tile	

Blank casing diameter 2 in. Was casing pulled? Yes No ___ If yes, how much **Drilled out to 20 feet**
 Casing height above or below land surface _____ in.

6 GROUT PLUG MATERIAL: 1 Neat cement 2 Cement grout 3 Bentonite 4 Other _____

Grout Plug Intervals From _____ ft. to _____ ft. From _____ ft. to _____ ft. From _____ ft. to _____ ft.

What is the nearest source of possible contamination:

- | | | | |
|--------------------------|-------------------|-------------------------|---------------------------------|
| 1 Septic tank | 6 Seepage pit | 11 Fuel storage | 16 <u>Other (specify below)</u> |
| 2 Sewer lines | 7 Pit privy | 12 Fertilizer storage | T&C #35 Lust Site |
| 3 Watertight sewer lines | 8 Sewage lagoon | 13 Insecticide storage | |
| 4 Lateral lines | 9 Feedyard | 14 Abandoned water well | |
| 5 Cess Pool | 10 Livestock pens | 15 Oil well/ Gas well | |

Direction from well? _____ How many feet? _____

FROM	TO	CODE	PLUGGING MATERIALS
0	20		Bentonite

7 CONTRACTOR'S OR LANDOWNER'S CERTIFICATION: This water well was plugged under my jurisdiction and was completed on (mo/day/yr) **2/7/06** and this record is true to the best of my knowledge and belief. Kansas Water Well Contractor's License No. **416** This Water Well Record was completed on (mo/day/yr) **2/24/06** under the business name of **Terracon Consultants, Inc.**

by (signature) *Steve Lisch*

INSTRUCTIONS: Please fill in blanks and circle the correct answers. Send three copies to Kansas Department of Health and Environment, Bureau of Water, 1000 S W Jackson St., Ste. 420, Topeka, Kansas 66620-0001. Telephone: 785-296-3565. Send one to Water Well Owner and retain one for your records.