

CORRECTED


WATER WELL RECORD Form WWC-5 KSA 82a-1212

1 LOCATION OF WATER WELL: County: Cowley Fraction SE 1/4 NE 1/4 SW 1/4 Section Number 21 Township Number T 32 S Range Number R 4 E/W

Distance and direction from nearest town or city street address of well if located within city? 303 N. Main, Winfield

2 WATER WELL OWNER: Valley Coop RR#, St. Address, Box #: 1916 E. 9th, Box 536 City, State, ZIP Code: Winfield, KS 67156 Board of Agriculture, Division of Water Resources Application Number:

3 LOCATE WELL'S LOCATION WITH AN "X" IN SECTION BOX:

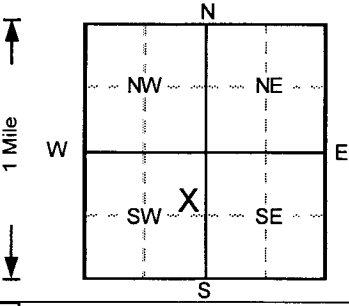

4 DEPTH OF COMPLETED WELL: 15 ft. ELEVATION: 1118.7 Depth(s) Groundwater Encountered: 1. ft. 2. ft. 3. ft. WELL'S STATIC WATER LEVEL: 11.62 ft. below land surface measured on mo/day/yr: 2/19/2007 Pump test data: Well water was NA ft. after hours pumping gpm Est. Yield NA gpm Well water was ft. after hours pumping gpm Bore Hole Diameter 8 in. to 15 ft. and in. to ft. WELL WATER TO BE USED AS: 5 Public water supply 8 Air conditioning 11 Injection well 1 Domestic 3 Feedlot 6 Oil field water supply 9 Dewatering 12 Other (Specify below) 2 Irrigation 4 Industrial 7 Lawn and garden only 10 Monitoring Well Was a chemical/bacteriological sample submitted to Department? Yes No If yes, mo/day/yr sample was submitted Water Well Disinfected? Yes No

5 TYPE OF BLANK CASING USED: 1 Steel 2 PVC 3 RMP (SR) 4 ABS 5 Wrought iron 6 Asbestos-Cement 7 Fiberglass 8 Concrete tile 9 Other (specify below) CASING JOINTS: Glued Clamped Welded Threaded Blank casing diameter 2 in. to 5 ft. Dia in. to ft. Dia in. to ft. Casing height above land surface -4.2 in., weight lbs./ft. Wall thickness or gauge No. Sch. 40 TYPE OF SCREEN OR PERFORATION MATERIAL: 1 Steel 2 Brass 3 Stainless steel 4 Galvanized steel 5 Fiberglass 6 Concrete tile 7 PVC 8 RMP (SR) 9 ABS 10 Asbestos-cement 11 Other (specify) 12 None used (open hole) SCREEN OR PERFORATION OPENINGS ARE: 1 Continuous slot 2 Louvered shutter 3 Mill slot 4 Key punched 5 Gauzed wrapped 6 Wire wrapped 7 Torch cut 8 Saw cut 9 Drilled holes 10 Other (specify) 11 None (open hole) SCREEN-PERFORATED INTERVALS: From 5 ft. to 15 ft. GRAVEL PACK INTERVALS: From 4 ft. to 15 ft.

6 GROUT MATERIAL: 1 Neat cement 2 Cement grout 3 Bentonite 4 Other Concrete Grout Intervals: From 0 ft. to 1 ft. From 1 ft. to 4 ft. What is the nearest source of possible contamination: 1 Septic tank 2 Sewer lines 3 Watertight sewer lines 4 Lateral lines 5 Cess pool 6 Seepage pit 7 Pit privy 8 Sewage lagoon 9 Feedyard 10 Livestock pens 11 Fuel storage 12 Fertilizer storage 13 Insecticide storage 14 Abandoned water well 15 Oil well/Gas well 16 Other (specify below) Direction from well? How many feet?

Table with columns: FROM, TO, LITHOLOGIC LOG, FROM, TO, PLUGGING INTERVALS. Row 1: 0, 1, Topsoil, , , Row 2: 1, 15, Clay, Brown, , ,

CORRECTED

MW7, Tag # 0041217, Flushmount Project Name: GeoStat - Valley Coop GeoCore # 1370, #

7 CONTRACTOR'S OR LANDOWNER'S CERTIFICATION: This water well was constructed, reconstructed, or plugged under my jurisdiction and was completed on (mo/day/year) 2/15/2007 and this record is true to the best of my knowledge and belief. Kansas Water Well Contractor's License No. 527. This Water Well Record was completed on mo/day/yr 3-12-2007 under the business name of GeoCore, Inc. by (signature) Doe