WATER WELL RECORD Form WWC-5 KSA 82a-1212 ID No. MW-7

1 LOCATION OF WATER WELL: County: Cowley | Fraction: NW ¼ NW ¼ NW ¼ | Section Number: 26 | Township Number: T 32 S | Range Number: R 4 (E) W

Distance and direction from nearest town or city street address of well if located within city?
2124 E. 9th Street, Winfield, Kansas

2 WATER WELL OWNER: K-B, Inc.
RR#, St. Address, Box # : P.O. Box 4119
City, State, ZIP Code : Wichita, Kansas 67204
Board of Agriculture, Division of Water Resources Application Number:

3 LOCATE WELL'S LOCATON WITH AN "X" IN SECTION BOX:

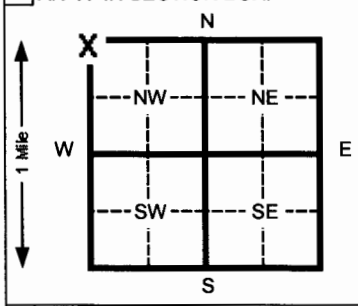

4 DEPTH OF COMPLETED WELL 10.0 ft. ELEVATION:
Depth(s) Groundwater Encountered 1 NA ft. 2 ft. 3 ft.
WELL'S STATIC WATER LEVEL 7.67 ft. below land surface measured on mo/day/yr 10/05/07
Pump test data: Well water was ft. after hours pumping gpm
Est. Yield NA gpm: Well water was ft. after hours pumping gpm
Bore Hole Diameter 8.5 in. to 10.0 ft. and in. to ft.
WELL WATER TO BE USED AS: 1 Domestic 3 Feed lot 5 Public water supply 6 Oil field water supply 8 Air conditioning 9 Dewatering 11 Injection well 12 Other (Specify below)
2 Irrigation 4 Industrial 7 Lawn and garden (domestic) (10) Monitoring well
Was a chemical/bacteriological sample submitted to Department? Yes No If yes, mo/day/yr sample was submitted Water Well Disinfected? Yes No X

5 TYPE OF BLANK CASING USED: (2) PVC | 1 Steel | 3 RMP (SR) | 4 ABS | 5 Wrought Iron | 6 Asbestos-Cement | 7 Fiberglass | 8 Concrete tile | 9 Other (specify below)
CASING JOINTS: Glued Clamped Welded Threaded X
Blank casing diameter 2.375 in. to 5.0 ft., Dia in. to ft., Dia in. to ft.
Casing height above land surface Flush Mount in., weight lbs./ft. Wall thickness or gauge No. Schedule 40
TYPE OF SCREEN OR PERFORATION MATERIAL: (7) PVC | 1 Steel | 2 Brass | 3 Stainless steel | 4 Galvanized steel | 5 Fiberglass | 6 Concrete tile | 8 RMP (SR) | 9 ABS | 10 Asbestos-cement | 11 Other (specify) | 12 None used (open hole)
SCREEN OR PERFORATION OPENINGS ARE: (3) Mill slot | 1 Continuous slot | 2 Louvered shutter | 4 Key punched | 5 Gauzed wrapped | 6 Wire wrapped | 7 Torch cut | 8 Saw cut | 9 Drilled holes | 10 Other (specify) | 11 None (open hole)
SCREEN-PERFORATED INTERVALS: From 10.0 ft. to 5.0 ft. From ft. to ft.
From ft. to ft. From ft. to ft.
GRAVEL PACK INTERVALS: From 10.0 ft. to 3.0 ft. From ft. to ft.
From ft. to ft. From ft. to ft.

6 GROUT MATERIAL: 1 Neat cement (2) Cement grout (3) Bentonite 4 Other
Grout Intervals From 0.0 ft. to 1.0 ft. From 1.0 ft. to 5.0 ft. From ft. to ft.
What is the nearest source of possible contamination:
1 Septic tank | 2 Sewer lines | 3 Watertight sewer lines | 4 Lateral lines | 5 Cess pool | 6 Seepage pit | 7 Pit privy | 8 Sewage lagoon | 9 Feedyard | 10 Livestock pens | (11) Fuel storage | 12 Fertilizer storage | 13 Insecticide storage | 14 Abandoned water well | 15 Oil well/ Gas well | 16 Other (specify below)
Direction from well? North How many feet? 110

FROM	TO	CODE	LITHOLOGIC LOG
0.0	4.5		Gray-brown very silty clay, firm-very firm, slightly moist; discolored dark gray, strong hydrocarbon odor
4.5	6.5		Olive green very silty clay, firm-very firm, slightly moist; discolored dark gray, strong Hydrocarbon odor
6.5	10.0		Tan weathered shale, very firm, slightly moist; hydrocarbon odor
10.0			Limestone, cherty, extremely hard
			Flush-mount well completion waiver existent for site.

7 CONTRACTOR'S OR LANDOWNER'S CERTIFICATION: This water well was (1) constructed, (2) reconstructed, or (3) plugged under my jurisdiction and was completed on (mo/day/yr) 09/26/07 and this record is true to the best of my knowledge and belief. Kansas Water Well Contractor's License No. 692 This Water Well Record was completed on (mo/day/yr) 10/03/05 under the business name of Quad State Services, Inc. by (signature)

INSTRUCTIONS:. Please fill in blanks and circle the correct answers. Send three copies to Kansas Department of Health and Environment, Bureau of Water, 1000 S W Jackson St., Ste. 420, Topeka, Kansas 66612-1367. Telephone: 913-296-5545. Send one to WATER WELL OWNER and retain one for your records.

OFFICE USE ONLY T R SEC