


1 LOCATION OF WATER WELL: County: Cowley Fraction NW 1/4 NW 1/4 NW 1/4 Section Number 26 Township Number T 32 S Range Number R 4

Distance and direction from nearest town or city street address of well if located within city? 2124 E. 9th Street, Winfield, Kansas

2 WATER WELL OWNER: K-B, Inc. RR#, St. Address, Box #: P.O. Box 4119 City, State, ZIP Code: Wichita, Kansas 67204 Board of Agriculture, Division of Water Resources Application Number:

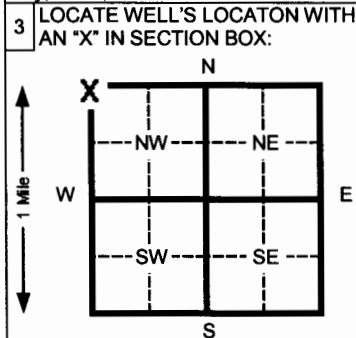

3 LOCATE WELL'S LOCATION WITH AN 'X' IN SECTION BOX: 4 DEPTH OF COMPLETED WELL 5.0 ft. ELEVATION: Depth(s) Groundwater Encountered 1 NA ft. 2 ft. 3 ft. WELL'S STATIC WATER LEVEL Dry ft. below land surface measured on mo/day/yr 10/05/07

5 TYPE OF BLANK CASING USED: 1 Steel, 2 PVC, 3 RMP (SR), 4 ABS, 5 Wrought Iron, 6 Asbestos-Cement, 7 Fiberglass, 8 Concrete tile, 9 Other (specify below), CASING JOINTS: 10 Asbestos-cement, 11 Injection well, 12 Other (specify below) Threaded X

6 GROUT MATERIAL: 1 Neat cement, 2 Cement grout, 3 Bentonite, 4 Other, Grout Intervals From 0.0 ft. to 1.0 ft. From 1.0 ft. to 2.0 ft. What is the nearest source of possible contamination: 1 Septic tank, 2 Sewer lines, 3 Watertight sewer lines, 4 Lateral lines, 5 Cess pool, 6 Seepage pit, 7 Pit privy, 8 Sewage lagoon, 9 Feedyard, 10 Livestock pens, 11 Fuel storage, 12 Fertilizer storage, 13 Insecticide storage, 14 Abandoned water well, 15 Oil well/ Gas well, 16 Other (specify below)

Table with columns FROM, TO, CODE. Rows: 0.0 TO 4.5, 4.5 TO 5.0

LITHOLOGIC LOG: Brown-red brown very silty clay, firm, moist; Limestone, cherty, very hard-extremely hard; Flush-mount well completion waiver existent for site.

7 CONTRACTOR'S OR LANDOWNER'S CERTIFICATION: This water well was (1) constructed, (2) reconstructed, or (3) plugged under my jurisdiction and was completed on (mo/day/yr) 09/26/07 and this record is true to the best of my knowledge and belief. Kansas Water Well Contractor's License No. 692 This Water Well Record was completed on (mo/day/yr) 10/03/05 under the business name of Quad State Services, Inc. by (signature)

OFFICE USE ONLY

T R

SEC