


1 LOCATION OF WATER WELL: Fraction SW 1/4 SE 1/4 SW 1/4 Section Number 21 Township Number T 32 S Range Number R 4 E/W

Distance and direction from nearest town or city street address of well if located within city? ~470'N of NW corner of Fifth Ave. & Menor St.

2 WATER WELL OWNER: Winfield Farmers Union Coop RR#, St. Address, Box # : P.O. Box 536 Board of Agriculture, Division of Water Resources City, State, ZIP Code : Winfield, Kansas 67156 Application Number:

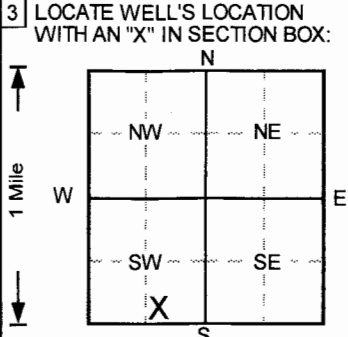

3 LOCATE WELL'S LOCATION WITH AN "X" IN SECTION BOX: 4 DEPTH OF COMPLETED WELL 20 ft. ELEVATION: 1121.6. WELL'S STATIC WATER LEVEL... Pump test data: Well water was NA ft. after... hours pumping... gpm. Est. Yield NA gpm. Bore Hole Diameter 8 in. to 20 ft. WELL WATER TO BE USED AS: 10 Monitoring well. Was a chemical/bacteriological sample submitted to Department? No. Water Well Disinfected? No.

5 TYPE OF BLANK CASING USED: 1 Steel, 2 PVC, 3 RMP (SR), 4 ABS, 5 Wrought iron, 6 Asbestos-Cement, 7 Fiberglass, 8 Concrete tile, 9 Other (specify below), 10 Asbestos-cement. Casing height above land surface 33.72 in., weight lbs./ft. Wall thickness or gauge No. Sch. 40. TYPE OF SCREEN OR PERFORATION MATERIAL: 7 PVC, 8 RMP (SR), 10 Asbestos-cement. SCREEN OR PERFORATION OPENINGS ARE: 3 Mill slot, 5 Gauzed wrapped, 8 Saw cut, 11 None (open hole). SCREEN-PERFORATED INTERVALS: From 5 ft. to 20 ft. GRAVEL PACK INTERVALS: From 4 ft. to 20 ft.

6 GROUT MATERIAL: 1 Neat cement, 2 Cement grout, 3 Bentonite, 4 Other. Grout Intervals: From 0 ft. to 1 ft., From 1 ft. to 4 ft. What is the nearest source of possible contamination: 1 Septic tank, 2 Sewer lines, 3 Watertight sewer lines, 4 Lateral lines, 5 Cess pool, 6 Seepage pit, 7 Pit privy, 8 Sewage lagoon, 9 Feedyard, 10 Livestock pens, 11 Fuel storage, 12 Fertilizer storage, 13 Insecticide storage, 14 Abandoned water well, 15 Oil well/Gas well, 16 Other (specify below). Direction from well? How many feet?

Table with columns: FROM, TO, LITHOLOGIC LOG, FROM, TO, PLUGGING INTERVALS. Rows include lithology descriptions like 'Clay and gravel', 'Clay, silty, v. moist, Dark Gray Brown', etc. Includes well identification: MW10, Tag # 0042844, Abovegrade. Project Name: Winfield Farmers Union Coop - Monitorin. GeoCore # 502, KDHE # U2 018 01355.

7 CONTRACTOR'S OR LANDOWNER'S CERTIFICATION: This water well was (1) constructed, (2) reconstructed, or (3) plugged under my jurisdiction and was completed on (mo/day/year) 9/15/2008 and this record is true to the best of my knowledge and belief. Kansas Water Well Contractor's License No. 527. This Water Well Record was completed on (mo/day/yr) 10/6/2008 under the business name of GeoCore, Inc. by (signature) Dale A. Bell

INSTRUCTIONS: Use typewriter or ball point pen. PLEASE PRESS FIRMLY and PRINT clearly. Please fill in blanks, underline or circle the correct answers. Send top three copies to Kansas Department of Health and Environment, Bureau of Water, Topeka, Kansas 66620-0001. Telephone: 913-296-5545. Send one to WATER WELL OWNER and retain one for your records.